
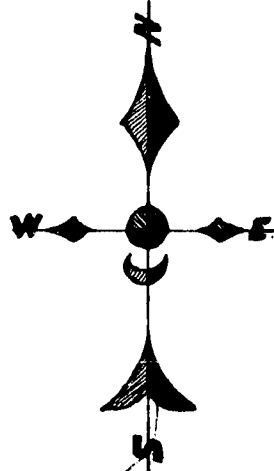


Map of Staudacher's Addition to West Bay City

Fred. Staudacher
Proprietor

Scale 100 Feet to 1 Inch

C. Glaser
Surveyor

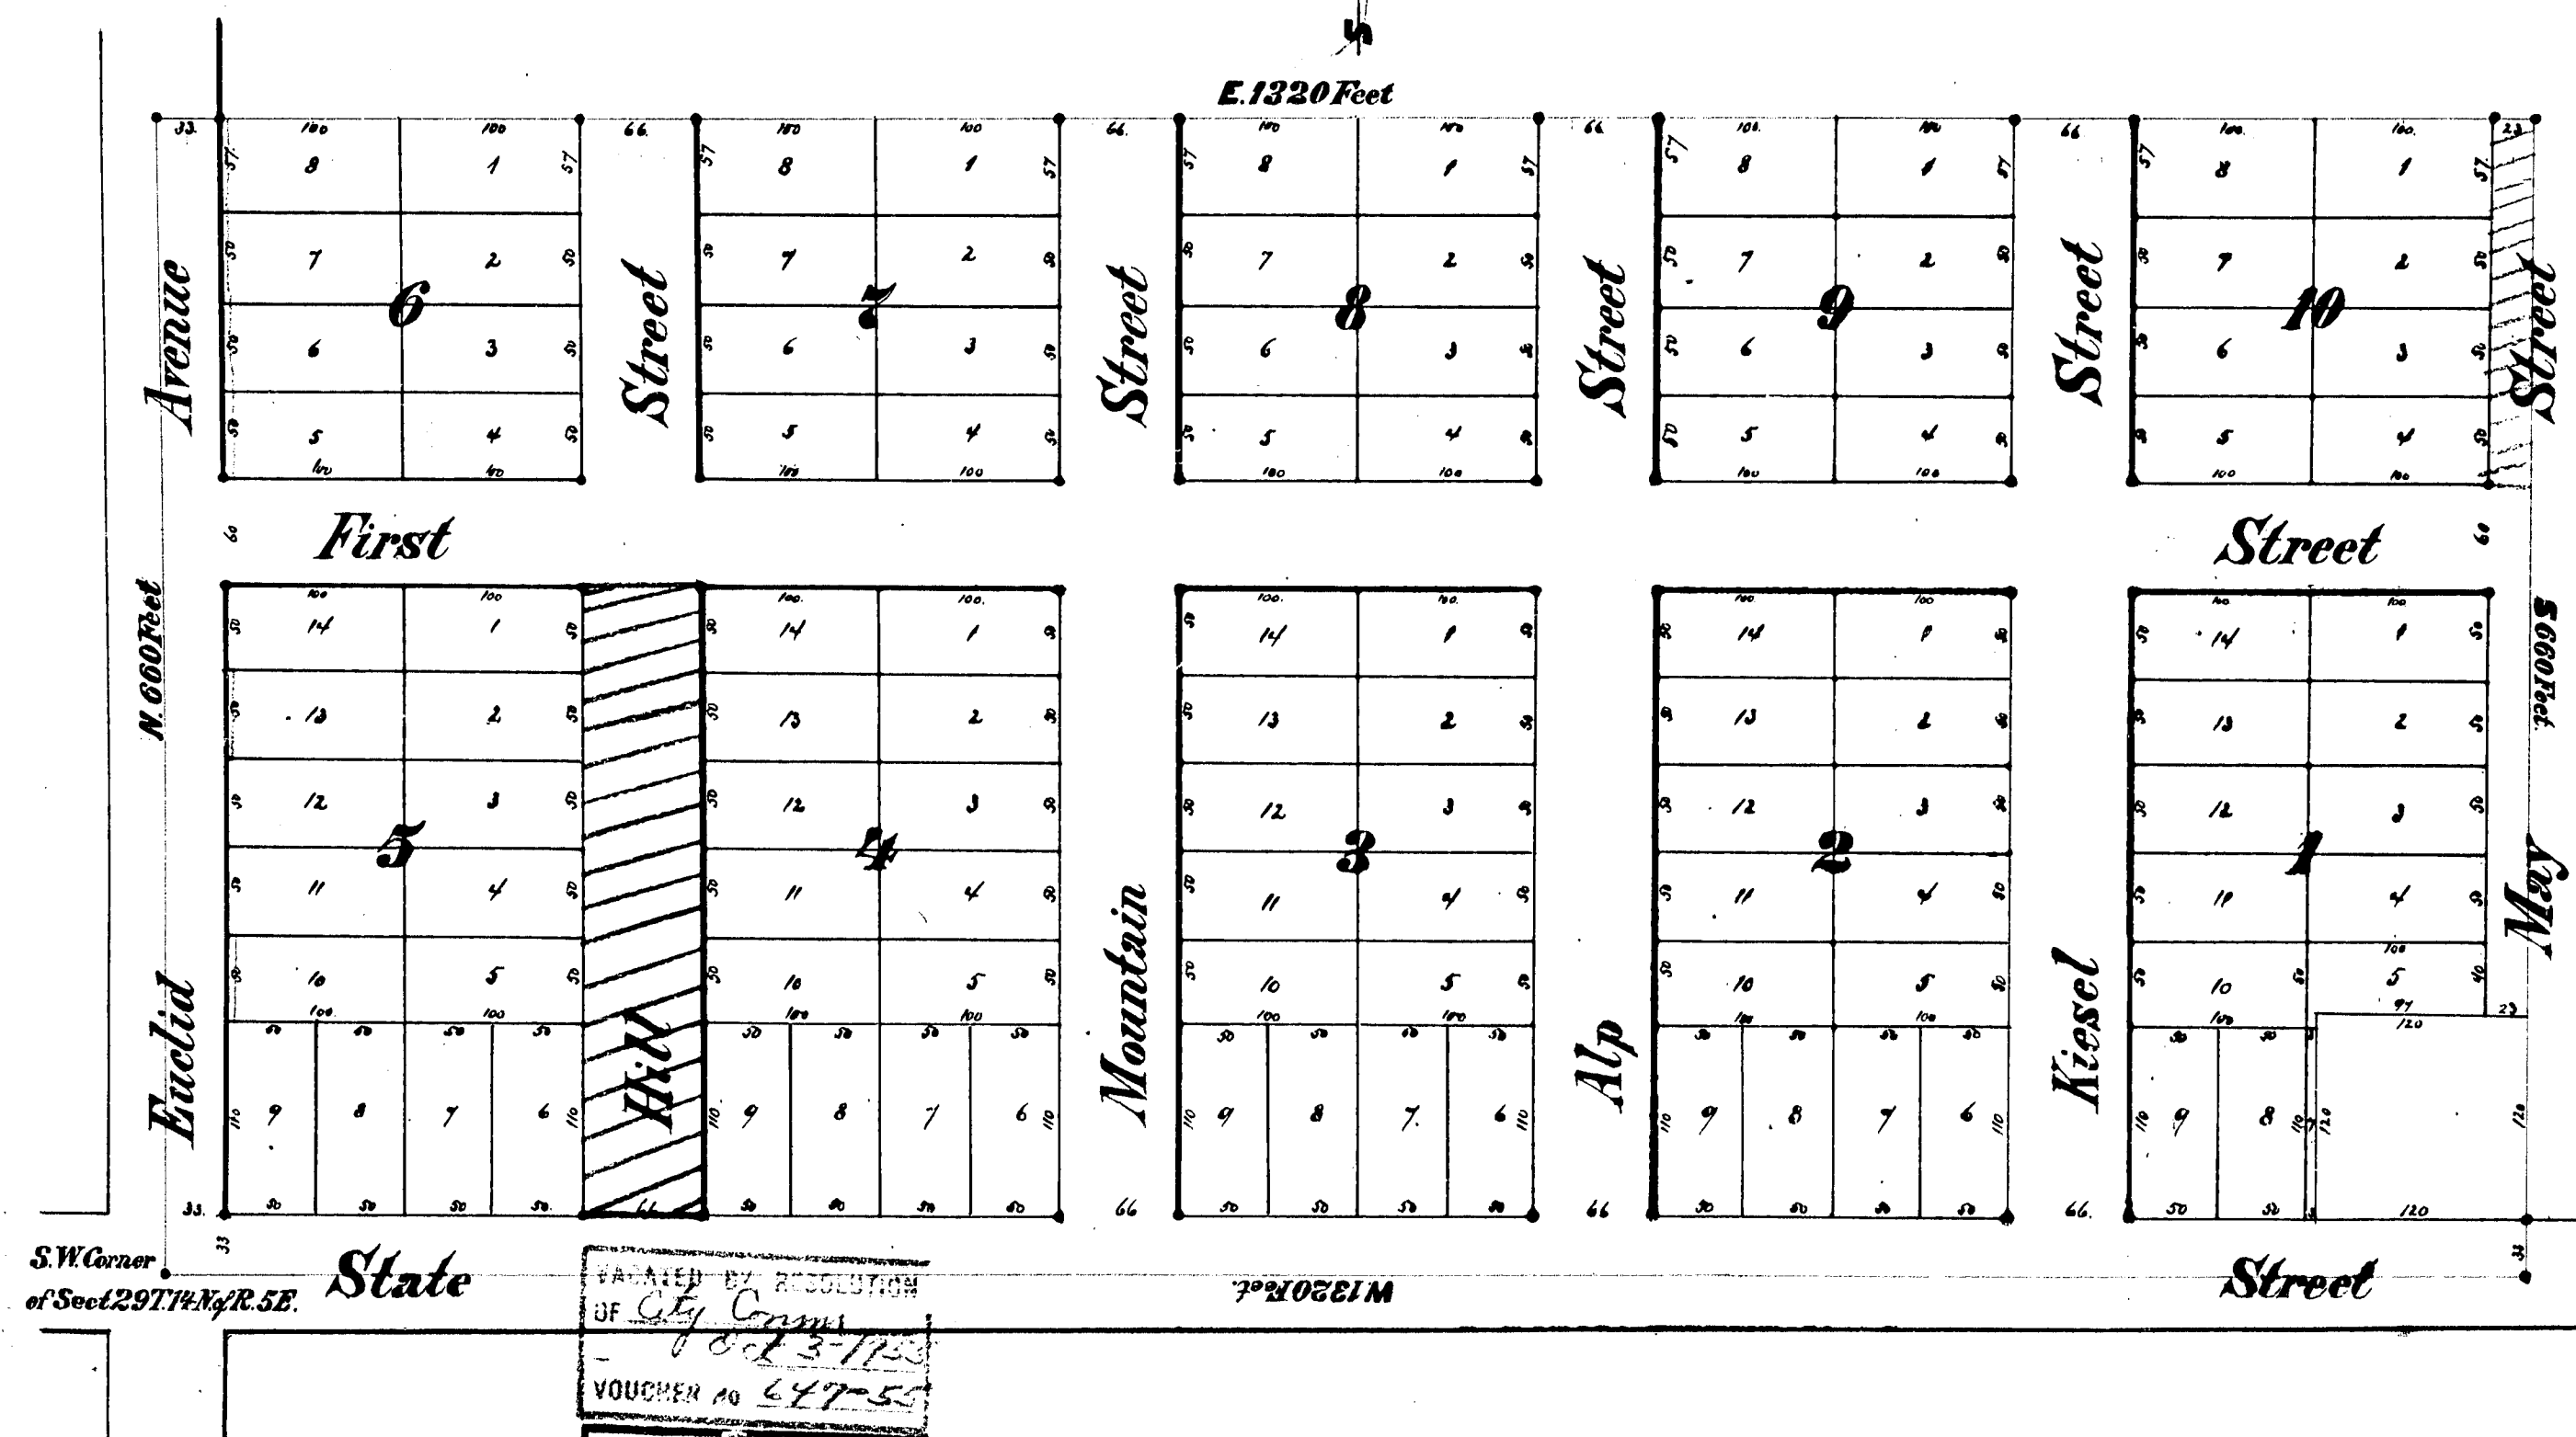

Description.



Surveyors Certificate.

I do hereby certify, that the plat herein delineated is a correct one and that permanent monuments consisting of one inch round iron have been planted at points marked, thus as thereon shown at all angles in the boundaries of the land platted, and at all intersections of streets.

Charles Glaser
Surveyor

Dedication.

Know all Men by these presents, That we Frederick Staudacher and Rosina Staudacher, his wife, have caused the land embraced in the annexed plat to be surveyed, laid out and platted, to be known as "Staudacher's Addition to West Bay City" and that the streets as shown on said Plat are hereby dedicated to the use of the public.

Signed and sealed in presence of
Charles Glaser
M. Riegel

Frederick Staudacher {L.S.}
Rosina Staudacher {L.S.}

State of Michigan } S.S.
County of Bay

On this Twenty fifth day of April 1894 before me as Notary Public in and for said County personally came the above named Frederick Staudacher and Rosina Staudacher, his wife, known to me to be the persons who executed the above dedication and acknowledged the same to be their free act and deed.

Charles Glaser
Notary Public in and for Bay County, Mich.

Approved by the Common Council of West Bay City Mich. this 23rd day of April A. D. 1894
R. D. Grump
Mayor

Examined and approved April 28th 1894

S. A. Singer,
Deputy Auditor General

State of Michigan } S.S.
County of Bay

Received for record this 2nd day of June 1894 and recorded in Plat book N 23 on page 35
Henry Denton
Register

State of Michigan } S.S.
County of Bay

Henry Denton Register of deeds and Charles Glaser, Surveyor, hereby certify, that we have both carefully compared this copy with the original Plat of Staudacher's Addition to West Bay City and that it is an exact copy thereof and of the whole of such original Map as Plat in to West Bay City and that it is in full conformity with the whole of such record.

Henry Denton
Charles Glaser
Register
Surveyor

State of Michigan } S.S.
County of Bay

Henry Denton Register of deeds and Charles Glaser, Surveyor, hereby certify, that we have both carefully compared this annexed copy with the Plat of Staudacher's Addition to West Bay City now on record in the office of said Register of deeds and that it is in full conformity with the whole of such record.

Henry Denton
Charles Glaser
Register
Surveyor

RECEIVED AND FILLED
IN CLERK GENERAL'S OFFICE



June 16 1894
S. A. Singer
Deputy Auditor General

Map of Staudacher's Addition to West Bay City

Fred Staudacher
Proprietor

Scale 100 Feet to 1 Inch

C. Glaser
Surveyor

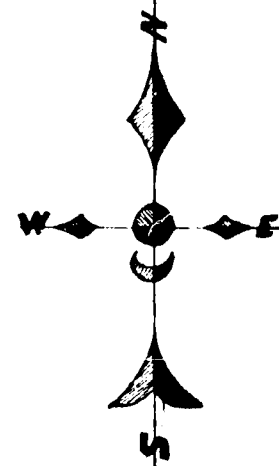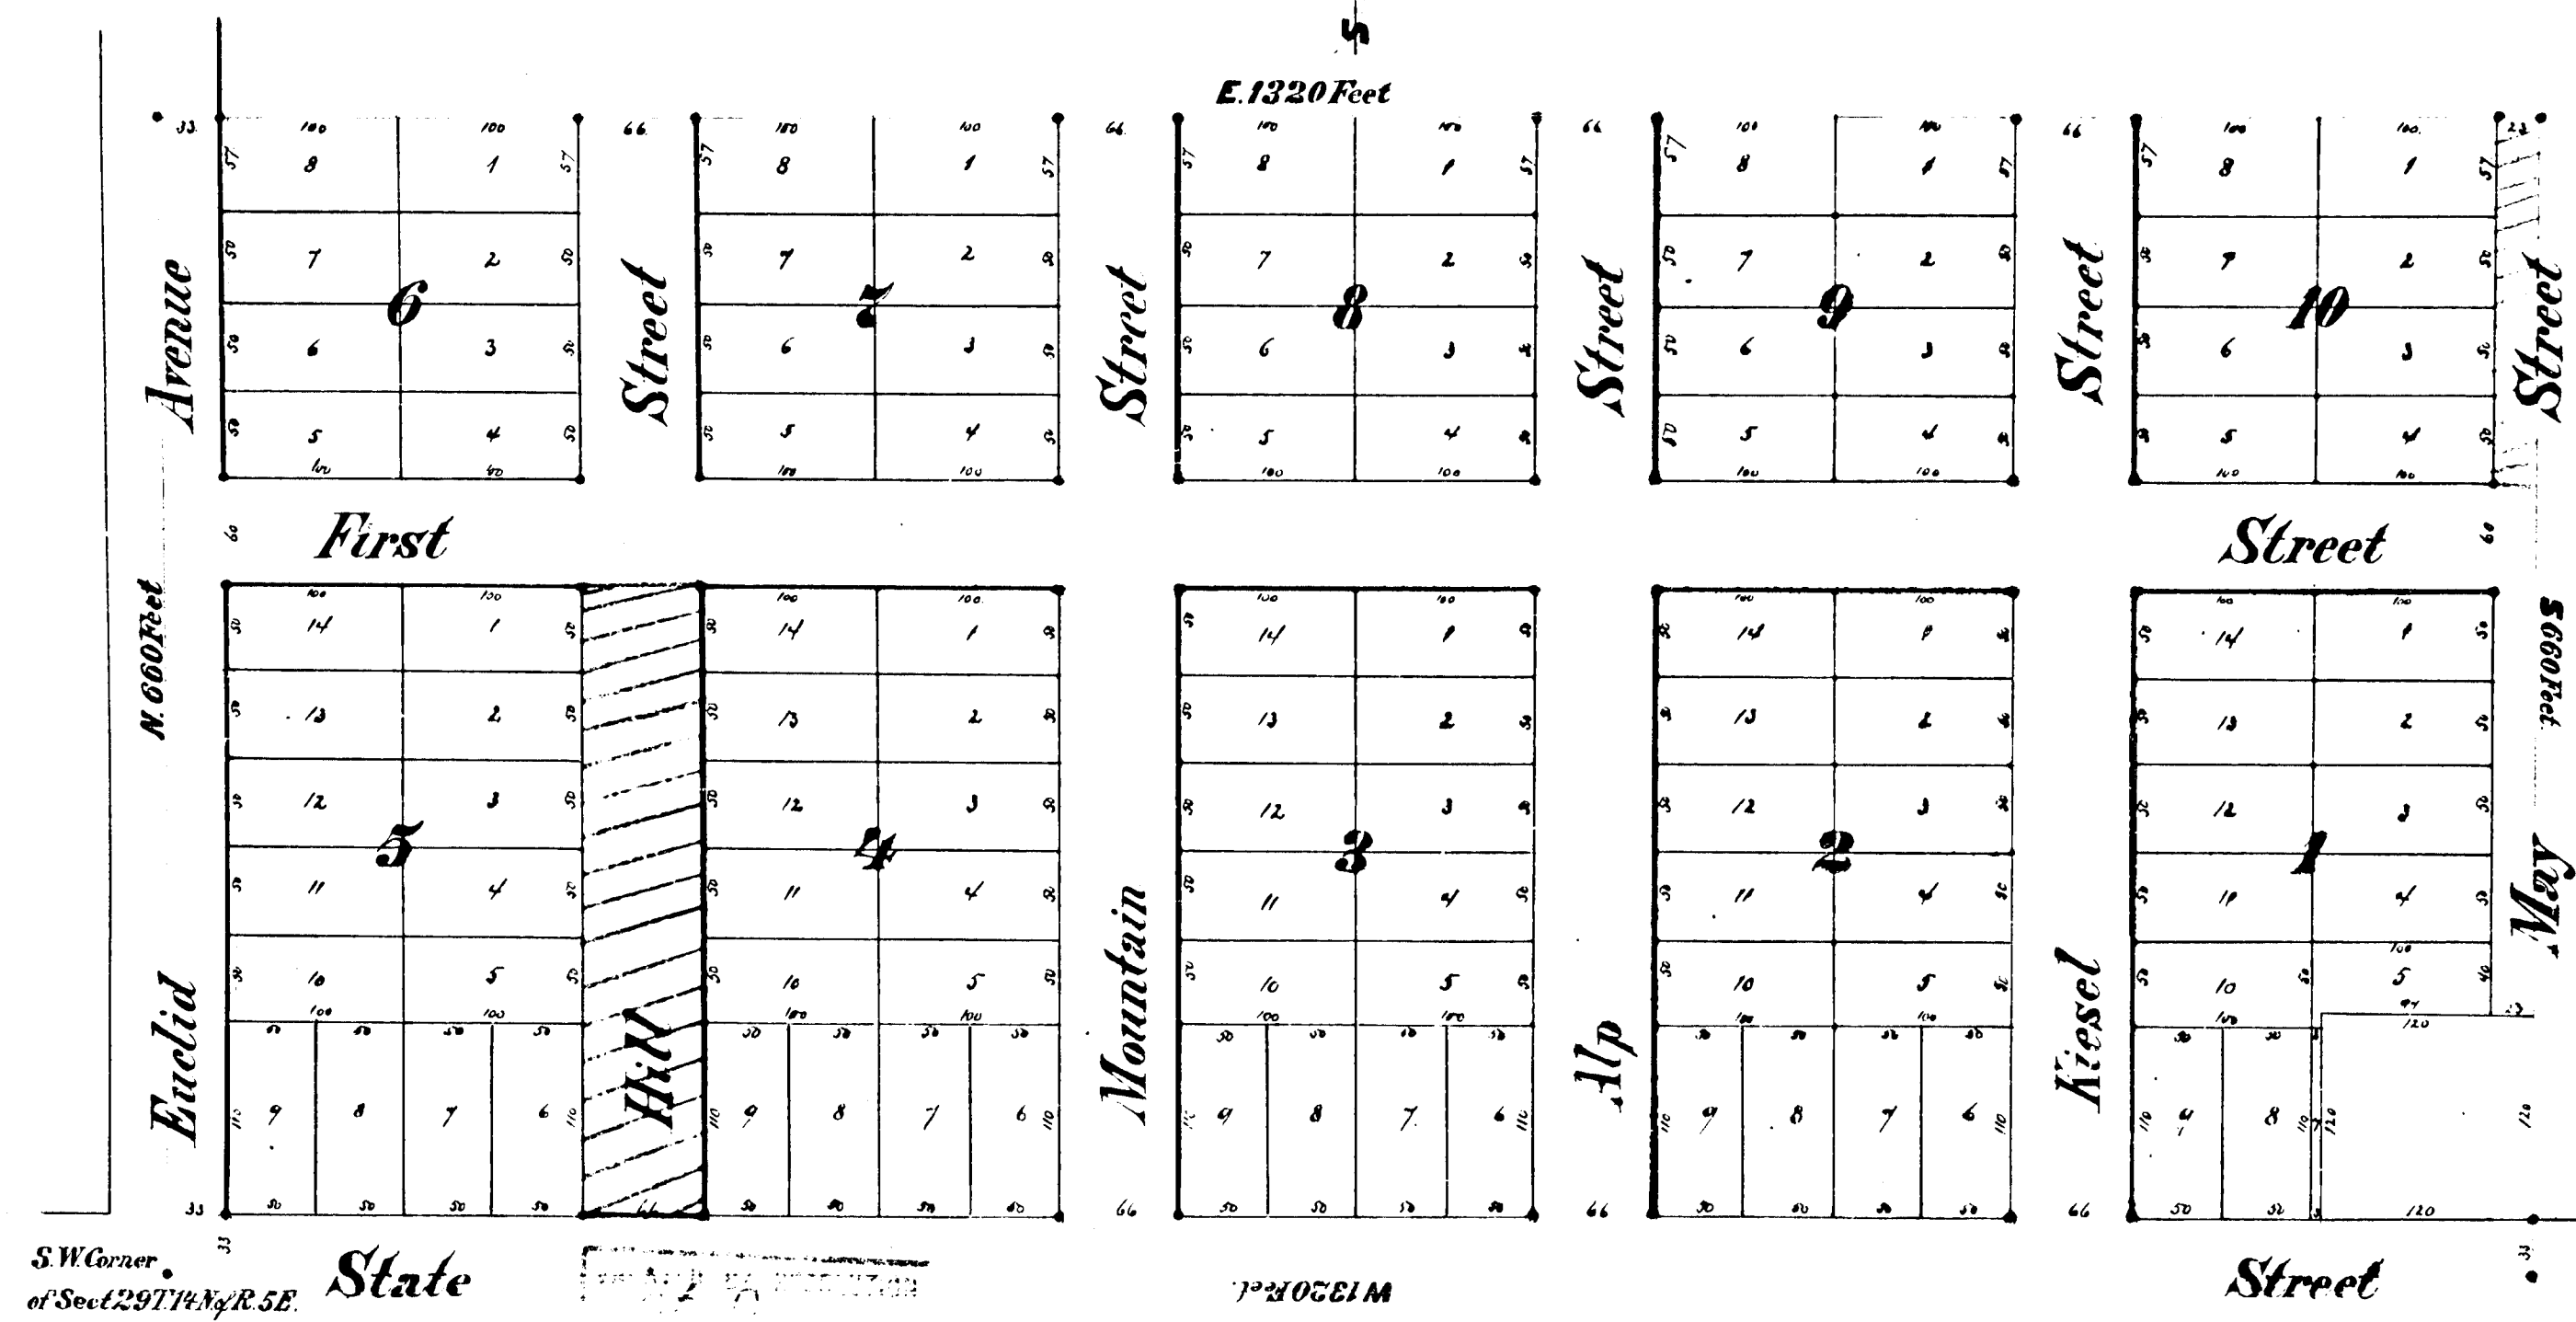

Description.

Beginning at the S.W. Corner of Section 29 Town 14 North of Range 5 East, running thence N. along the Section Line 660 feet, thence E. and parallel with the E. line of said Section 1320 feet to Sub 1/4 line, thence S. and along said Sub 1/4 line 660 feet to South line of said Section 29, thence E. and along said South Section Line 1320 feet to place of beginning, the same land being the S.E. 1/4 of the S.W. 1/4 of Section 29 Town 14 North of Range 5 East.

Surveyors Certificate.

I do hereby certify, that the plat herein delineated is a correct one and that permanent monuments consisting of one inch round iron have been planted at points marked, thus as thereon shown at all angles in the boundaries of the land platted, and at all intersections of streets.

Charles Glaser
Surveyor

Dedication.

Know all Men by these presents, That we, Frederick Staudacher and Rosina Staudacher, his wife, have caused the land embraced in the annexed plat to be surveyed, laid out and platted, to be known as "Staudacher's Addition to West Bay City" and that the streets as shown on said Plat are hereby dedicated to the use of the public.

Signed and sealed in presence of
Charles Glaser
M. Riegel

Frederick Staudacher {L.S.}
Rosina Staudacher {L.S.}

State of Michigan }
County of Bay }

On this Twenty first Day of April 1894, before me as Notary Public in and for said County personally came the above named Frederick Staudacher and Rosina Staudacher, his wife, known to me to be the persons, who executed the above dedication and acknowledged the same to be their free act and deed.

Charles Glaser
Notary Public in and for Bay County, Mich.

Attested by the Common Council of West Bay City Mich. this 23rd Day of April A. D. 1894
R. D. Grump
Mayor

W. C. Lusk
Recorder

Examined and approved April 28th 1894

D. A. Singer

State of Michigan }
County of Bay }

Received for record this 2nd Day of June 1894 and recorded in Plat book N 3 on page 35
Henry Benton
Register

State of Michigan }
County of Bay }

Henry Benton Register of deeds and Charles Glaser, Surveyor, hereby certify, that we have both carefully compared this copy with the original Plat of "Staudacher's Addition to West Bay City" and that it is a true and correct copy thereof and of the whole of said original Map, a Plat

Henry Benton
Charles Glaser
Register
Surveyor

State of Michigan }
County of Bay }

We Henry Benton Register of deeds and Charles Glaser, Surveyor, hereby certify, that we have both carefully compared this annexed copy with the Plat of "Staudacher's Addition to West Bay City" now on record in the office of said Register of deeds, and that it is a true transcript therefrom and of the whole of said record.

Henry Benton
Charles Glaser
Register
Surveyor

FILED AND FILED

DEEDS RECORDS OFFICE

June 16 1894

D. A. Singer

Deputy Auditor