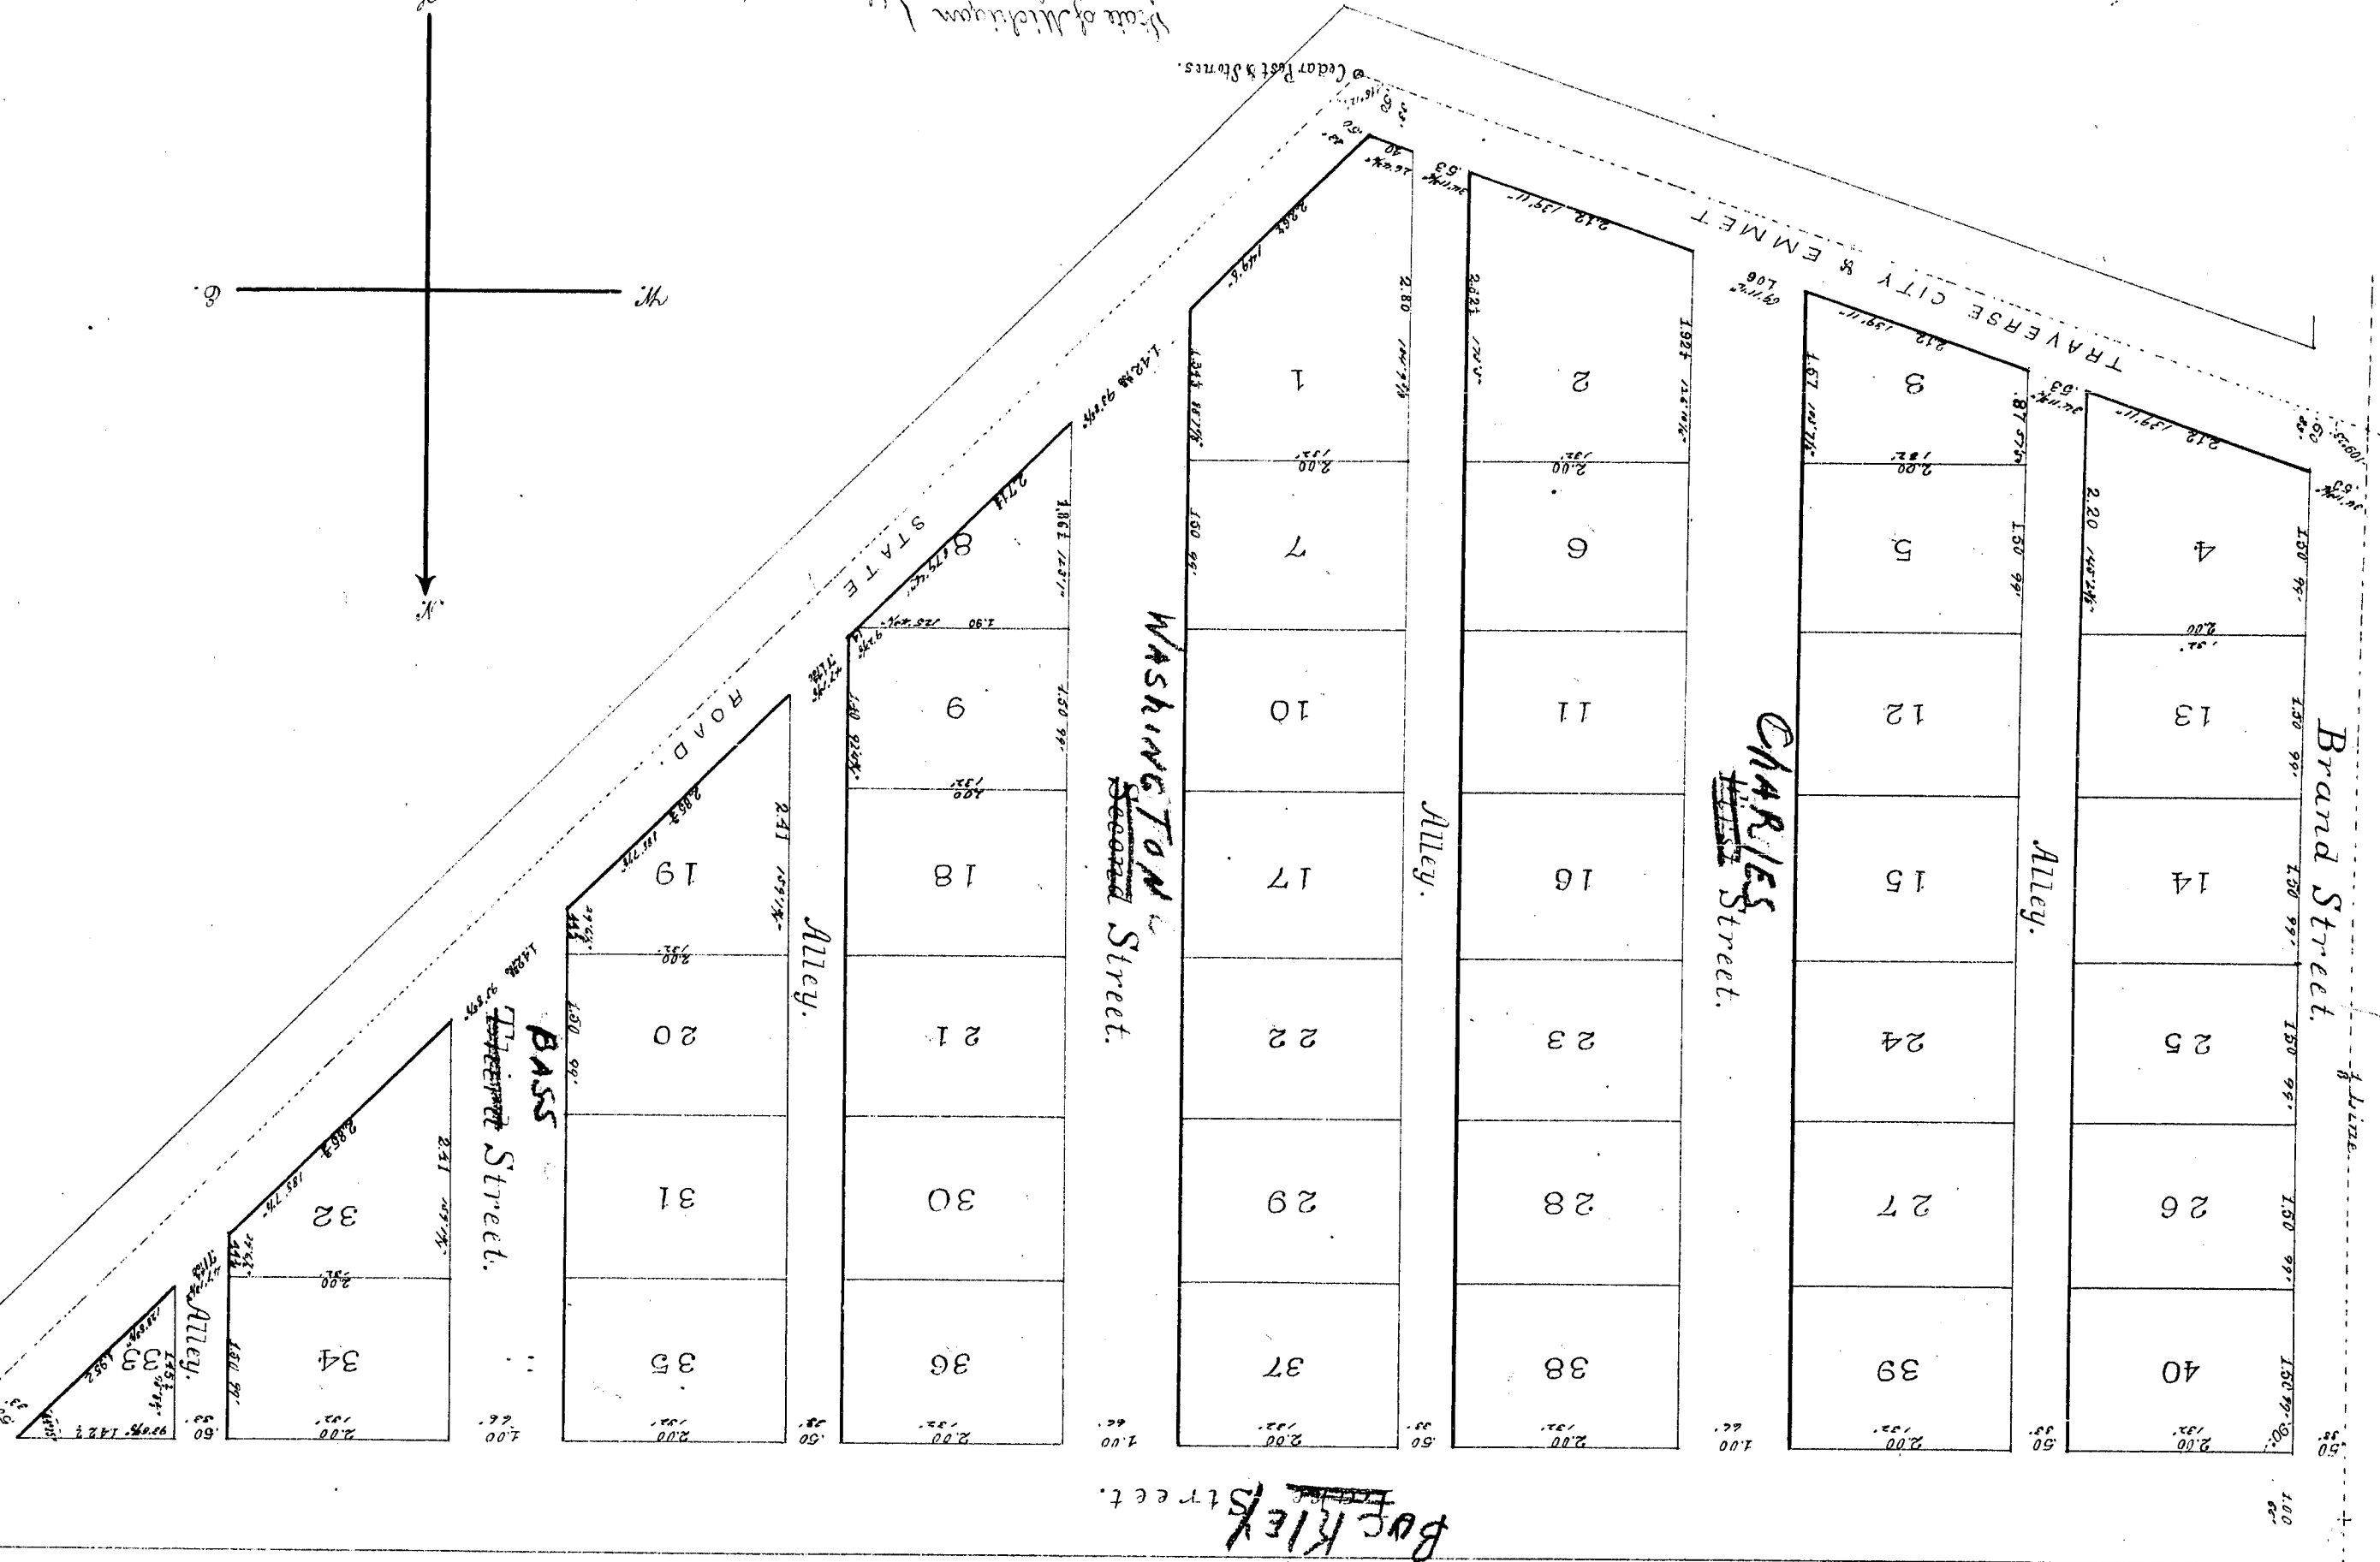


CRAWS ADDITION
To The
VILLAGE OF
ELK RAPIDS
MICH.


VACATED BY RESOLUTION
OF Village Council
Sept 7-54
VOUCHER NO 219-24

[illegible][illegible]




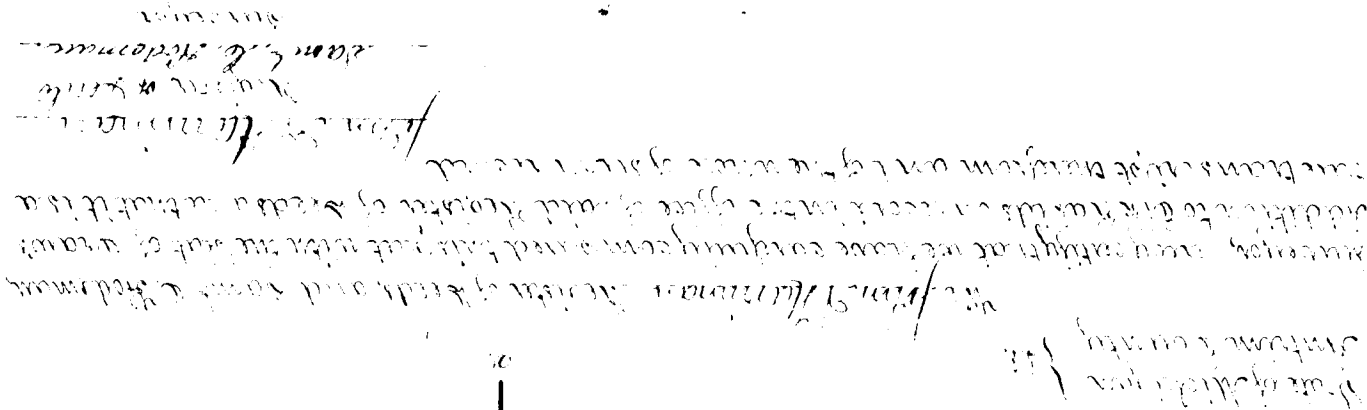

In testimony whereof I have hereunto set my hand and seal this 19th day of July 1895.

Wm. J. Condit
 Clerk of the Court

State of Michigan }
 of the County of }
 in the }
 County of }
 in and for said County, personally appeared the said Wm. J. Condit, who executed this plat, who acknowledged the same to be his act and deed.

[illegible]


[illegible]

LIBER 332 PAGE 949 ANTRIM COUNTY MICHIGAN RECEIVED FOR RECORD Oct 24 10 14 AM '88

RESOLUTION 88-36 - VACATION OF ALL RIGHTS-OF-WAY BOUNDED BY IROQUOIS ST. (FORMERLY FIRST ST.), AMES ST., BRAND ST. AND LAKE ST.

WHEREAS: THE VILLAGE OF ELK RAPIDS MAINTAINS A STREET SYSTEM FOR THE BENEFIT OF THE RESIDENTS, AND WHEREAS: THE VILLAGE CONSIDERS IT ADVISABLE TO VACATE ALL RIGHTS-OF-WAY WITHIN THE BLOCK BOUNDED BY IROQUOIS ST. (FORMERLY FIRST ST.), AMES ST., BRAND ST. AND LAKE ST., BEING ORIGINALLY PLATTED AS A PART OF GRANT'S ADDITION TO THE VILLAGE OF ELK RAPIDS AND WHICH PROPERTY HAS THE FOLLOWING DIMENSIONS TO WIT: A WIDTH OF 33' (THIRTY-THREE FEET) FOR THE ENTIRE LENGTH, WHICH EXTENDS FROM THE SOUTH BOUNDARY OF LAKE ST., SOUTH APPROXIMATELY 640' TO THE NORTH BOUNDARY OF AMES ST.,


4-41 THEREFORE: THE COUNCIL OF THE VILLAGE OF ELK RAPIDS DOES HEREBY 4-32 DECLARE AND BY THIS RESOLUTION DOES VACATE ALL RIGHTS-OF-WAY WITHIN THE BLOCK BOUNDED BY IROQUOIS ST. (FORMERLY FIRST ST.), AMES ST., BRAND ST. AND LAKE ST., THE WIDTH OF 33' FOR THE ENTIRE LENGTH, WHICH EXTENDS FROM THE SOUTH BOUNDARY OF LAKE ST., SOUTH APPROXIMATELY 640' TO THE NORTH BOUNDARY OF AMES ST.

YAYS: 7 NAYS: 0 ABSENT: 0 Elaine A. Glowicki I, ELAINE A. GLOWICKI, VILLAGE CLERK, DO HEREBY CERTIFY THAT THE ABOVE RESOLUTION 88-36 WAS DULY APPROVED AT THE REGULAR COUNCIL MEETING HELD ON 7/5/88. RESOLUTION DECLARED ADOPTED.

STATE OF MICHIGAN County of Antrim On this 21st day of 1988 in the year of one thousand nine hundred and eighty-eight before me, the subscriber, in and for said County, personally appeared, Elaine A. Glowicki, to me known to be the same person described in, and who executed the within instrument, who has acknowledged the same to be her free act and deed.

Mary E. Chole Notary Public

My Commission expires: MARY E. CHOLE, NOTARY PUBLIC ANTRIM COUNTY, MICHIGAN MY COMMISSION EXPIRES 6-8-92 ANTRIM COUNTY MICHIGAN

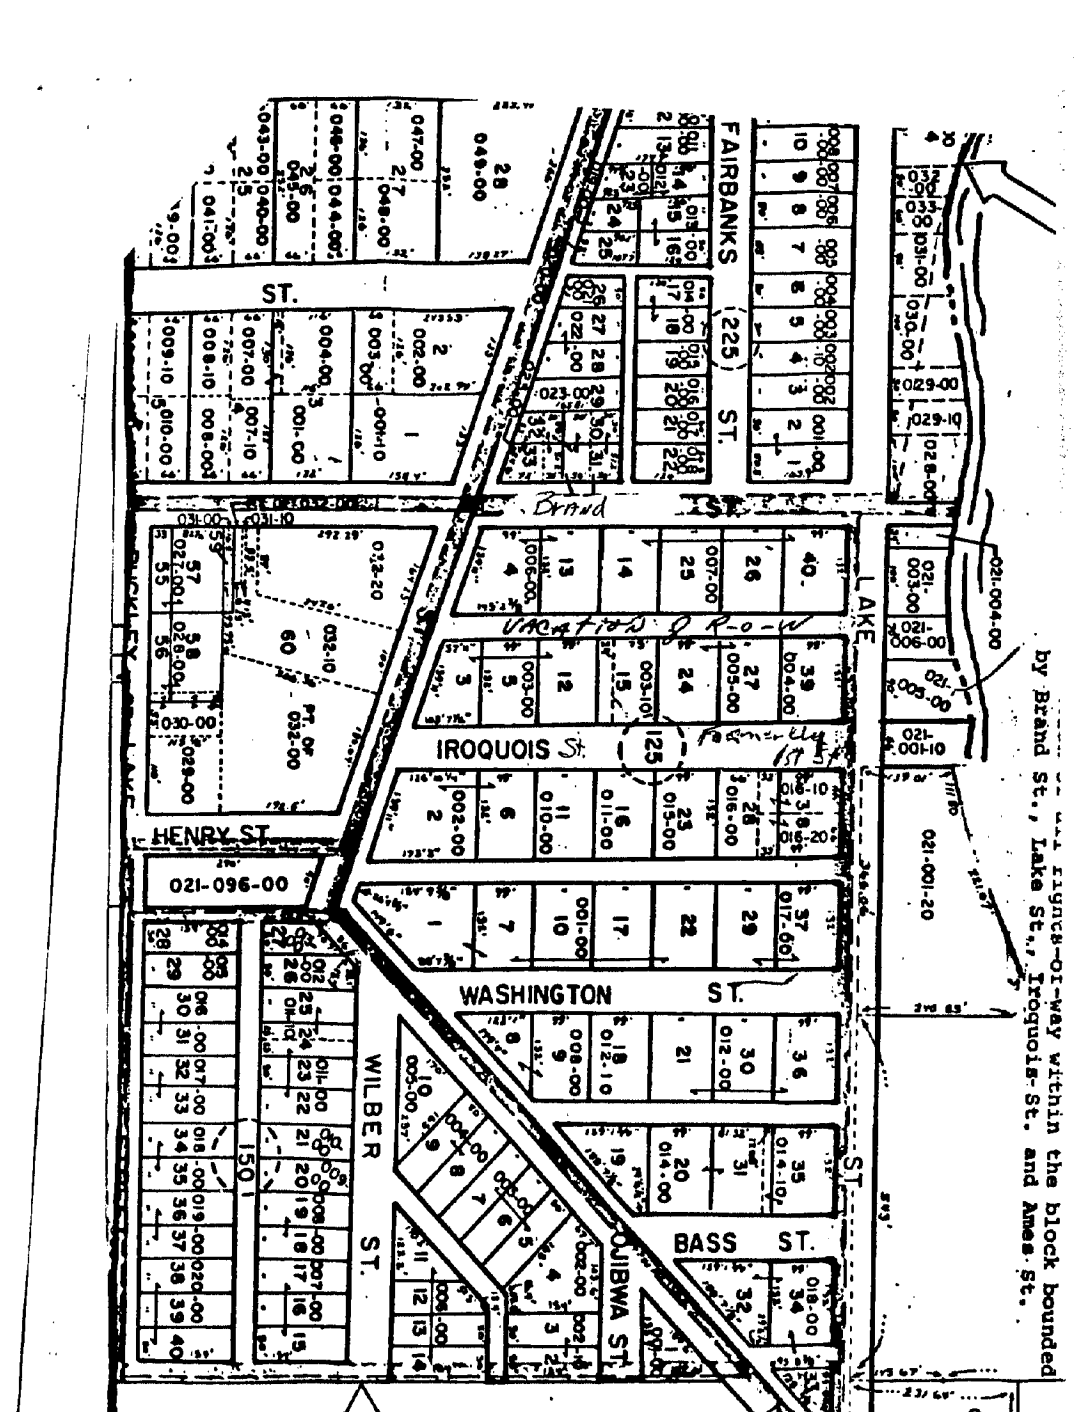

THE VILLAGE OF ELK RAPIDS

PHONE: VILLAGE HALL (616) 264-9274
PUBLIC WORKS 264-9671
ELK RAPIDS, MICHIGAN 49629

MARCH 30, 1988

REGISTER OF DEEDS
P.O. BOX 295
BELLAIRES, MICHIGAN 49615

ATTN: WANDA CONWAY

I, THE VILLAGE CLERK, ELAINE A. GLOWICKI, DO HEREBY CERTIFY THAT THE FOLLOWING MOTION WAS ACTED UPON BY VILLAGE COUNCIL AT THEIR REGULAR MEETING HELD ON MONDAY, MARCH 21, 1988.

MOTION BY MARLATT SUPPORTED BY TRUESDELL TO VACATE ALL RIGHTS-OF-WAY WITHIN THE BLOCK BOUNDED BY BASS ST., AMES ST. AND LAKE ST., BEING ORIGINALLY PLATTED AS A PART OF CRAW'S ADDITION TO THE VILLAGE OF ELK RAPIDS AND WHICH PROPERTY HAS THE FOLLOWING DIMENSIONS TO WIT: A WIDTH OF 33' (THIRTY-THREE FEET) FOR THE ENTIRE LENGTH, WHICH EXTENDS FROM THE SOUTH BOUNDARY OF LAKE ST., SOUTH APPROXIMATELY 95' TO THE NORTH BOUNDARY OF AMES ST.

ROLL CALL VOTE: RUTHERFORD, TRUESDELL, BRADFIELD, TSCHUDY, MARLATT, YUCHASZ, COOK. ALL MEMBERS PRESENT VOTING YES. MOTION CARRIED.

PLEASE RECORD THIS INFORMATION ACCORDINGLY AND RETURN A COPY TO THE VILLAGE FOR OUR FILES. PLEASE FEEL FREE TO CONTACT THIS OFFICE IF YOU NEED FURTHER INFORMATION.

SINCERELY,

ELAINE A. GLOWICKI
VILLAGE CLERK

eg

seal

cc: STATE TREASURER, ROBERT A. BOWMAN