4-6

Township No. V South, Range No. IV West (Uintah Sm.)

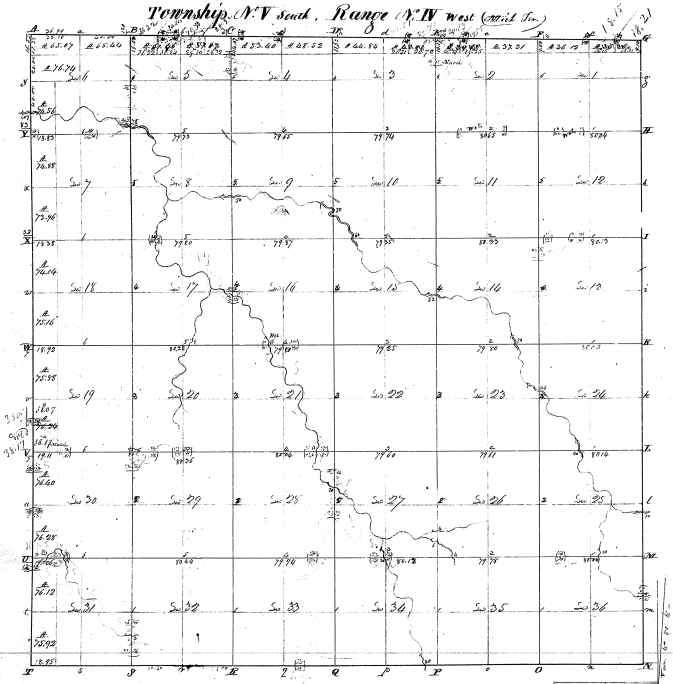

Surveys in September 1825 by Robert Clark Dep. S.S.

Sections	Contents Acres	Contents A/c
N½ NE¼	26	36
S½ "	80	
N½ NW¼	31	12
S½ "	80	
"	320	
N½ NE¼ 2	27	31
S½ "	80	
N½ NW¼ "	39	68
S½ "	80	
"	320	
N½ NE¼ 3	42	01
S½ "	80	
N½ NW¼ "	44	84
S½ "	80	
"	320	
N½ NE¼ 4	48	52
S½ "	80	
N½ NW¼ "	55	40
S½ "	80	
"	320	
N½ NE¼ 5	57	69
S½ "	80	
N½ NW¼ "	61	46
S½ "	80	
"	320	
N½ NE¼ 6	65	44
S½ "	80	
N½ NW¼ "	65	07
S½ "	74	76
S½ SE¼	160	
S½ SW¼	80	
N½	74	56
"	320	
S½ NW¼	80	
N½	74	88
S½ SW¼	80	
N½	73	96
Sec. 8	640	
9	640	
10	640	
11	640	
12	640	
13	640	
14	640	
15	640	
16	640	
17	640	
E½ 18	320	
S½ NW¼ "	80	
N½ "	74	64
S½ SW¼ "	80	
N½ "	75	16
E½ 19	320	
S½ NW¼ "	80	
N½ "	75	85
S½ SW¼ "	80	
N½ "	76	24
	11749	27

33

Sections	Contents A/c	
Sec. 20	640	
21	640	
22	640	
23	640	
24	640	
25	640	
26	640	
27	640	
28	640	
29	640	
E½ 30	320	
E½ NW¼ "	80	
N½ "	74	40
E½ SW¼ "	80	
N½ "	74	28
E½ 31	320	
E½ NW¼ "	80	
N½ "	74	12
E½ SW¼ "	80	
N½ "	75	98
Sec. 32	640	
33	640	
34	640	
35	640	
36	640	
	11844	72
	11749	27
	23613	99 Total

4-6