Not to be Meandered

Township No. 9 S. Range No. 3 W. Mer.

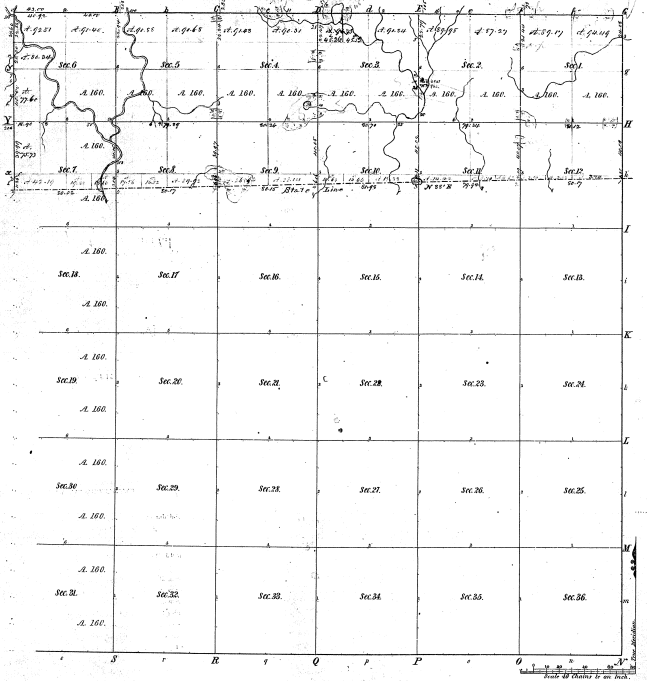

Meanders of							
Posts	Courses	W.Lat.	Posts	Courses	W.Lat.	Posts	Courses	W.Lat.

4-38

Total number of Acres. 6,177.72

Surveys Designated	By Whom Surveyed	Date of Contract	Amount of Surveys	When Surveyed	When 2nd or and 3rd on the Sur. Gen.'s ms.
Township lines			M. Ch. Lks.		
Subdivisions	Wm. Worthington			February 1855	

The above Map of Township No. 9 South, of Range No. 3 West in the Principal Meridian Michigan is strictly conformable to the field notes of the survey thereof on file in this Office, which have been examined and approved.

Surveyor General's Office, Lucius Lyons Sur. Gen.