Township No. 50 North Range No. 30 West Mer. Mich.

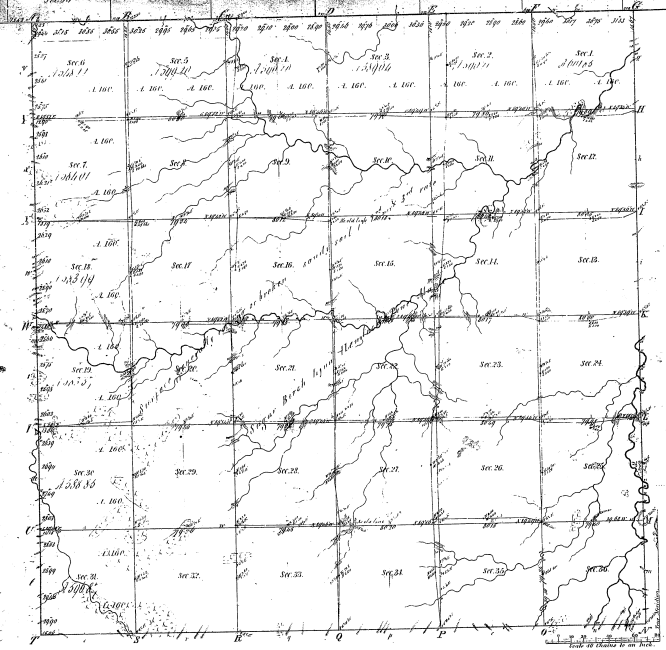

Meanders of								
Posts	Courses	Ch. Lk.	Posts	Courses	Ch. Lk.	Posts	Courses	Ch. Lk.

44-1

Total number of Acres 22469.00

Surveys Designated	By Whom Surveyed	Date of Contract	Amount of Surveys	When Surveyed	When pd. Ord. and Ch. to the Surv. Gen. Ld. Ofc.
Township lines	[illegible]	April 27 1847	4 Chs. 40 Lks.	2nd Quar. 1847	
Subdivisions	A. Merryweather	Bond Dec. 31st 1852	59 . 17 . 16	3rd & 4th Quar. 1853	

The above Map of Township No. 50 North of Range No. 30 West of the Principal Meridian Michigan is strictly conformable to the field notes of the survey thereof on file in this Office, which have been examined and approved.

Surveyor General's Office
Detroit Septr. 2nd 1853

Leander Chapman
Spr. Genl.