Township N.º 59 N. Range N.º 28 W. Mer. Mich.

40-22

Meanders of			
Posts	Courses	Chs. Lks.	Posts

Note

This entire fractional Township was "reserved for Light House purposes" by the President of the U.S. on the 3rd. of April 1847. as appears. by a letter of the Comm.r of the Genl Land Office dated 19th July 1847. on file in this Office. The Land Officers are not to permit, any sale or entry of any portion of the lands thus reserved, without specific instructions to that effect, from the Comm.r of the Genl. Land Office.

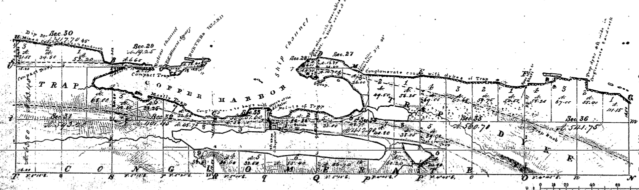

Total number of Acres 2920.35

Surveys Designated.	By Whom Surveyed.	Date of Contract.	Amount of Surveys. M. Chs. Lks.	When Surveyed.	When Charged in the Surr. Genl's acct.
Township lines	Wm. A. Burt	June 25. 1844	22 [illegible]	3rd qr. 1845	
Subdivisions	B. Houghton			3rd qr. 1845	

The above Map of Township N.º 59 North of Range N.º 28 West of the Principal Meridian, Michigan, is strictly conformable to the field notes of the survey thereof on file in this Office, which have been examined and approved.

Surveyor General's Office, Detroit, May 8. 1846

Lucius Lyon, Surr. Genl.