Township No. 14. N. Range No. 11. West Mer.d (Mich.)

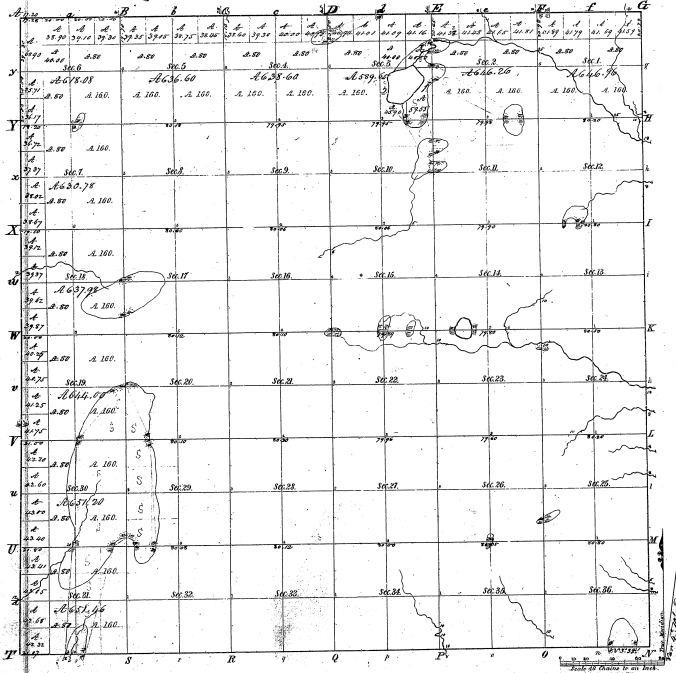

Total number of Acres 22791.57

Surveys Designated	By Whom Surveyed	Date of Contract	Amount of Surveys	When Surveyed	When of ex and cl's in the Surv.r Gen.l office
Exterior lines	[illegible]	[illegible]	[illegible]	[illegible]	[illegible]
Subdivisions	Chs. H. Kellog	Feb. 28. 1837	61. 31. 88	4th qr 1837	1st qr 1839

The above Map of Township No. 14 North of Range No. 11 West of the Principal Meridian Michigan is strictly conformable to the field notes of the surveys thereof on file in this office, and is hereby approved and confirmed.

Surveyor Generals Office
Cincinnati Feb. 22nd 1839

Sur. Gen.l

Meanders of the Lake in Section 3

Posts	Courses	Dist. Lks	Posts	Courses	Dist. Lks	Posts	Courses	Dist. Lks
Begs.								
	N 53 W	14.00						
	N 45 W	15.50						
	N 18 W	10.00						
	N 8 E	7.00						
	N 77 E	15.00						
	S 89 E	15.50						
	N 65 W	14.00						
	S 24 W	7.00						

11-26

11-26