36-27

Township No. 44 N. Range No. 13 W. Mer. Mich.

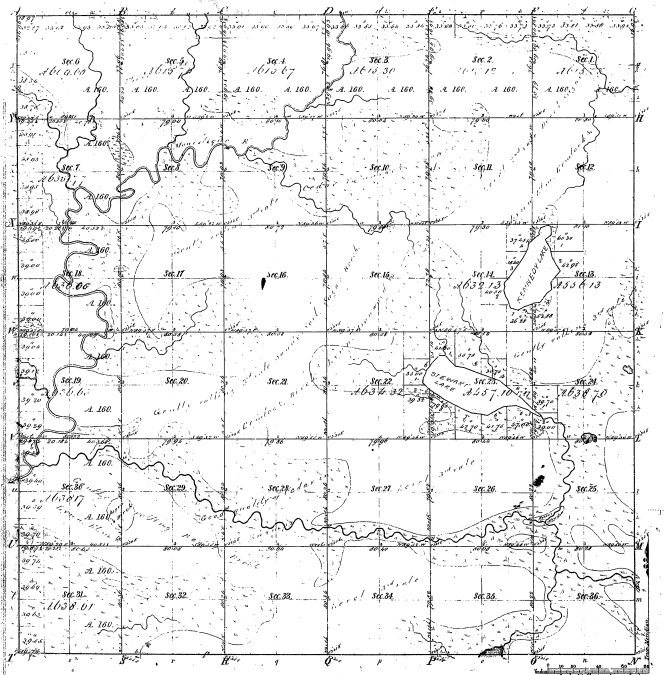

Meanders of								
Posts	Courses	Ch.s Lk.s	Posts	Courses	Ch.s Lk.s	Posts	Courses	Ch.s Lk.s

Meanders Amelia 7 Chains 30 Links

Total number of Acres 22590.52

Surveys Designated	By Whom Surveyed	Date of Contract	Amount of Surveys	When Surveyed	Chang.d for and ch.d to the Surv. Gen.l Ins.t
Township lines	Wm. Clark & Bart	April 1st 1841	M. 11 Chs. 76 Lks. 72	2d 3rd Quar. 1841	
Subdivisions	Cap. E. Carleton	July 14 1849	64 00 20	3rd Quar. 1850	

The above Map of Township No. 44 North of Range No. 13 West of the Principal Meridian Michigan is strictly conformable to the field notes of the survey thereof on file in this Office, which have been examined and approved.

Surveyor General's Office.
Detroit, Jan. 18. 1851

Charles Noble
Sur. Gen.l