Township No. 45 N. Range No. 17 W. Mer. Mich.

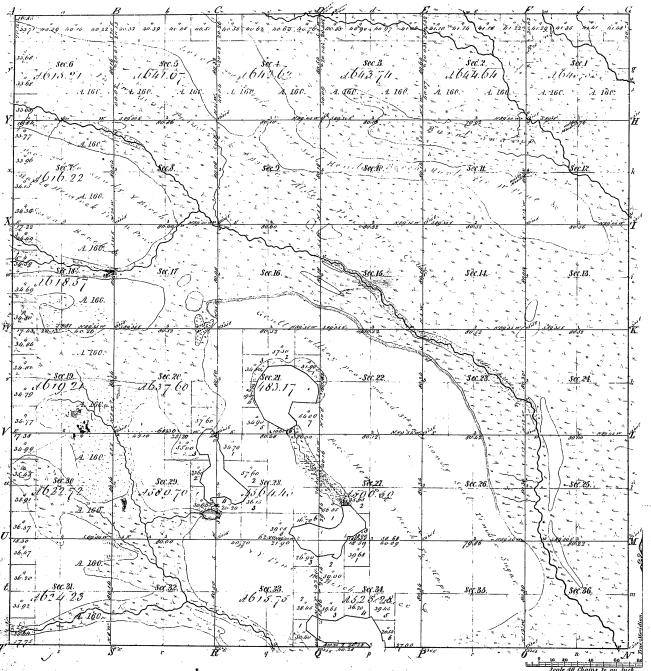

Meanders of								
Posts	Courses	Ch.s Lks	Posts	Courses	Ch.s Lks	Posts	Courses	Ch.s Lks

37-18

37-18

Total number of Acres 22460.79

Surveys Designated	By Whom Surveyed	Date of Contract	Amount of Surveys	When Surveyed	When p.d. for and ch.d to the Surv.r Gen.l acc.t
Township lines	W. A. Burt	April 1st 1841	M. Ch.s Lks 41 78 48	2nd Quar. 1841	
Subdivisions	William Ives	April 26 1850	66 76 86	3rd Quar. 1850	

The above Map of Township No. 45 North of Range No. 17 West of the Principal Meridian Michigan is strictly conformable to the field notes of the survey thereof on file in this Office, which have been examined and approved.

Surveyor General's Office.
Detroit March 5. 1851

Charles Noble
Spr. Gen.l