LAND CORNER RECORDATION CERTIFICATE

Authority: 1970 PA 74, MCL 54.205

Surveyor's Name: Stephan J. Szyszkoski

Field Survey Date: See below

For corner(s) in: Baraga County

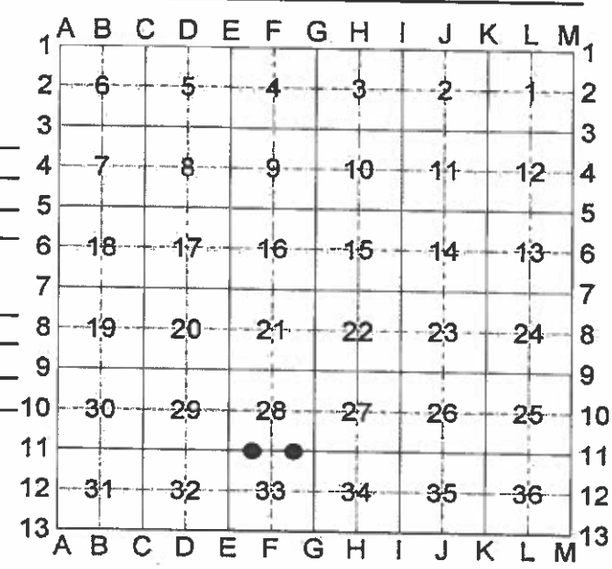

Original Public Land Survey Corner | **Corner Code**

S		T	R	
S		T	R	
S		T	R	
S		T	R	

Property Corner | **1/16 Corner Code**

a.	S	28	T 50N	R 34W	15 (GCDB 320200)
a.	S	33	T 50N	R 34W	1 (GCDB 320200)
b.	S	28	T 50N	R 34W	16 (GCDB 360200)
b.	S	33	T 50N	R 34W	2 (GCDB 360200)

Part A. Corner History

a.) West 1/16 corner between Sections 28 and 33. Not previously monumented.

b.) East 1/16 corner between Sections 28 and 33. Not previously monumented.

STATE OF MICHIGAN
STEPHAN J. SZYSZKOSKI
PROFESSIONAL SURVEYOR
No. 33986
LICENSED PROFESSIONAL SURVEYOR

Part B: Surveyor's Report on Perpetuation, Restoration, Reestablishment, or Monumentation of Corner

a.) May 10, 2017: Established the position for the corner midway and on the Section line between Section corner 1330.53' west and Quarter corner 1330.53' east.

b.) June 14, 2017: Established the position for the corner midway and on the Section line between Section corner 1330.53' east and Quarter corner 1330.53' west.

Part C: Field Evidence of Perpetuation or Monumentation of Corner

a.) Set 1"IDx28" I.pipe with 2" alum. MDNR cap.
Set measuring nail with MDNR tag in the side of:
8" Hemlock N20°E 23.95' mrkd "1/16S BT"
9" Maple S72°E 23.85' do
9" Sugar S16°E 4.2' do
12" Sugar N81°W 15.85' do
Set sq'd cedar post adjacent.
E= 7880005.260 N= 213530.998

b.) Set 1"x28" I.pipe with 2" alum. MDNR cap.
Set measuring nail with MDNR tag in the side of:
9" Hemlock N52°E 4.15' mrkd "1/16S BT"
13" Hemlock S56°E 23.9' do
8" Hemlock S69°W 10.0' do
12" Hemlock N40°W 5.25' do
Set sq'd cedar post adjacent.
E= 7880816.070 N= 213513.374

Bearings are magnetic. Coordinates are MCS83 in meters, NAD83(2011) Epoch 2010.00 datum.
Coord. Ref.=NGS PID DO8499: N= 221257.624 m. E= 7884435.169 m.

Stephan J. Szyszkoski 06/21/2017

Professional Surveyor's License No.: 33986

Prepared By: S.J. Szyszkoski for the Michigan Dept. of Natural Resources, 427 N. US41 Baraga, MI 49908