LAND CORNER RECORDATION CERTIFICATE

Filing Requirement of Act 74, Mich. P.A. 1970

For corners in CLARE (County)

	Located In:	Corner Code ##
1. Public Land Survey	T 20N R 5W	G-7, H-7
	T ___ R ___	
	T ___ R ___	
	T ___ R ___	
2. Property Controlling	S 22 T ___ R ___	1, 3
in Section	S ___ T ___ R ___	
3. Miscellaneous	S ___ T ___ R ___	
Property in Sec.	S ___ T ___ R ___	

Register of Deeds Stamp & File Number

4. Lot No. _____ , Recorded Plat _____
5. Private Claims _____

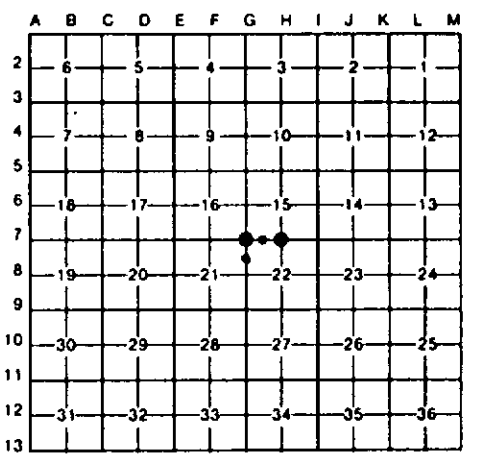

I, CARL F. ROSER, in a field survey on SEPTEMBER 19, 19 90, do hereby certify that under requirements of P.A. 74, Michigan P.A. of 1970, the corner points mentioned in lines 1 and 2 above were in conformance with regulations and rules therefore as required in the current manual of survey instructions of the United States Department of the Interior, Bureau of Land Management or by a decree of a Court of Law and/or that the corner points mentioned in lines 3, 4 and 5 above were in conformance with the rules of the Michigan Board of Land Surveyors or by a Decree of a Court of Law; established, re-established, monumented, re-monumented, recovered, found as expressed below:

NOTE: Not more than 4 corners, all in the same town and range, may be recorded on this certificate.

A. Description of original monument and accessories and/or subsequent restoration:

G-7 H-7 1 3

B. Description of corner evidence found and/or method applied in restoring or reestablishing corner:

G-7	H-7	1	3
ACCEPTED FD 1" PIPE W/RLS CAP FOR SE COR SEC 16. COR IS IN CTR E-W GRAVEL ROAD. CTR TRAIL S IS 54'± 3'W. FD OLD SHOT GUN BARREL S05°46'E, 28.0'. FD 1" PIPE WITNESSED AND USED BY GOURDIE-FRASER ASSOC.	REESTABLISHED 1/4 COR TO SEC 15 & 22 MIDWAY AND ON LINE BETWEEN SEC CORNERS. THIS FITS GOURDIE-FRASER SEC 15 SECTION SUB'N IN 1976.	ESTABLISHED NW COR OF NE 1/4 OF NW 1/4 OF SEC 22 PER STD BLM INSTRUCTIONS. CTR 28'± WIDE E-W GRAVEL ROAD IS 16' N.	ESTABLISHED NW COR OF SW 1/4 OF NW 1/4 OF SEC 22. PER STD BLM INSTRUCTIONS. CTR N-S MINDING TRAIL IS 8' W.

C. Description of monument for corner and accessories established to perpetuate locating the position of the corner:

G-7			H-7			1			3		
FD 1" RUSTY PIPE W/RLS CAP.			SET DNR MON & CED POST.			DROVE 5/8" X 34" REROD W/RLS CAP.			DROVE 5/8" X 34" REROD W/RLS CAP & SET CED POST W/LOC TAG.		
7" R PINE	N60°W	91.40'	22" B OAK	N35°W	99.45'	6" R PINE	N20°W	70.5'	7" J PINE	N50°W	43.2'
*17" OAK	N05°E	39.78'	13" R PINE	N20°E	74.25'	16" OAK	S65°E	38.6'	9" J PINE	N50°E	13.8'
*13" R PINE	S10°E	64.05'	21" B OAK	S25°E	32.33'	11" R PINE	S20°E	50.6'	4" J PINE	S40°E	11.8'
16" R PINE	S25°W	67.05'	17" B OAK	S10°W	84.74'	8" R PINE	S55°W	31.1'	16" B OAK	S15°W	80.1'
SET CED POST W/ LOC TAG	DUE N	33'				SET CED POST W/ LOC TAG.	SOUTH	17'	N-S RANDOM LINE	WEST	8'

*GOURDIE-FRASER & ASSOC. WITS.

Signed by Carl F. Roser 8-10-92 Date _____

Surveyor's Michigan License No. 12028

STATE OF MICHIGAN CARL F. ROSER LAND SURVEYOR 12028 REGISTERED LAND SURVEYOR

FORM APPROVED BY MICHIGAN STATE BOARD OF LAND SURVEYORS, JAN. 28, 1971
REVISED MAY 14, 1975
REVISED JAN., 1983