SURVEY &
REMONUMENTATION

SEP 0 8 1998

SECTION

LAND CORNER RECORDATION CERTIFICATE

Filing Requirement of Act 74, Mich. P.A. 1970

Register's Office } ss.
Gogebic County }

Received for record the 17TH day of MARCH A. D. 19 98 at 9:55 o'clock A m., and recorded in Liber 6 of CORNERS page 327

Ramona Collins Deputy
Register of Deeds

Register of Deeds Stamp & File Number

For corners in Gogebic (County)

	Located In:	Corner Code ##
1. Public Land Survey	T44N R 39W	M-12
	T R	
	T R	
	T44N R 38W	A-12
2. Property Controlling	S T R	
in Section	S T R	
3. Miscellaneous	S T R	
Property in Sec.	S T R	

4. Lot No. _____ , Recorded Plat _____
5. Private Claims _____

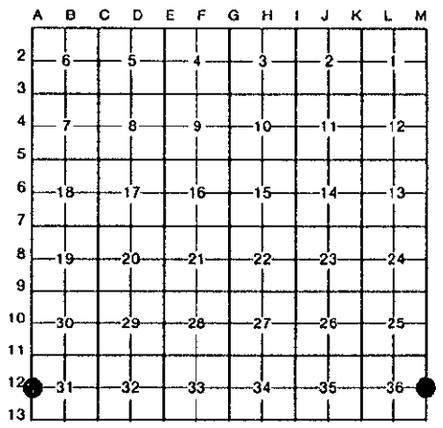

¼ Corner 36 & 31; T.44 N., R.38-39 W.

I, Richard L. Drahn in a field survey on December 9, , 19 97 , do hereby certify that under requirements of P.A. 74, Michigan P.A. of 1970, the corner points mentioned in lines 1 and 2 above were in conformance with regulations and rules therefore as required in the current manual of survey instructions of the United States Department of the Interior, Bureau of Land Management or by a decree of a Court of Law and/or that the corner points mentioned in lines 3, 4 and 5 above were in conformance with the rules of the Michigan Board of Land Surveyors or by a Decree of a Court of Law; established, re-established, monumented, re-monumented, recovered, found as expressed below:

NOTE: Not more than 4 corners, all in the same town and range, may be recorded on this certificate.

A. Description of original monument and accessories and/or subsequent restoration:

Corner established by Austin Burt on 7/2/1847. Original B.T.s --- Aspen 7" S.31 E. 21 links (13.86') --- B. Oak 8" N.60 W. 23 links (15.18') ---

Corner re-established by Gary Pisoni (27457) on 6/8/87 using single proportionate methods. He set a 2" X 30" alum. pipe with a 3¼" stamped aluminum cap and the following B.T.s:

7"	Hemlock	N.23 E.	47.14'
5"	Sugar Maple	S.37 E.	30.18'
4"	Sugar Maple	N.77 W.	27.32'
6'	Metal sign post	S.50 W.	1.00'

B. Description of corner evidence found and/or method applied in restoring or reestablishing corner:

Corner recorded in Gogebic County in Liber 3, Page 243 on 8/24/88.

Corner research on file with Gogebic County records.

Recovered Pisonis' monument as described and his B.T.s as follows.

8"	Hemlock	N.22 E.	47.18'
7"	Sugar Maple	S.38 E.	30.18'
4"	Sugar Maple	N.78 W.	27.32'
6'	Steel sign rail	S.41 W.	0.93'

No evidence of the GLO B.T.s recovered.

C. Description of monument for corner and accessories established to perpetuate locating the position of the corner:

New bearing tree referenced:

9"	Red Pine	N.16 W.	30.98'

PEER GROUP APPROVED
Richard L. Drahn 12/19/97
COUNTY REPRESENTATIVE

STATE OF MICHIGAN
RICHARD L. DRAHN LAND SURVEYOR No. 21564
REGISTERED LAND SURVEYOR

Signed by Richard L. Drahn Date December 12, 1997

Surveyor's Michigan License No. 21564

USFS X-25

FORM APPROVED BY MICHIGAN STATE BOARD OF LAND SURVEYORS, JAN. 28, 1971
REVISED MAY 14, 1975
REVISED JAN., 1983