LAND CORNER RECORDATION CERTIFICATE

Authority: 1970 PA 74, MCL 54.205

Surveyor's Name: Stephan J. Szyszkoski Field Survey Date: See below

For corner(s) in: Iron County

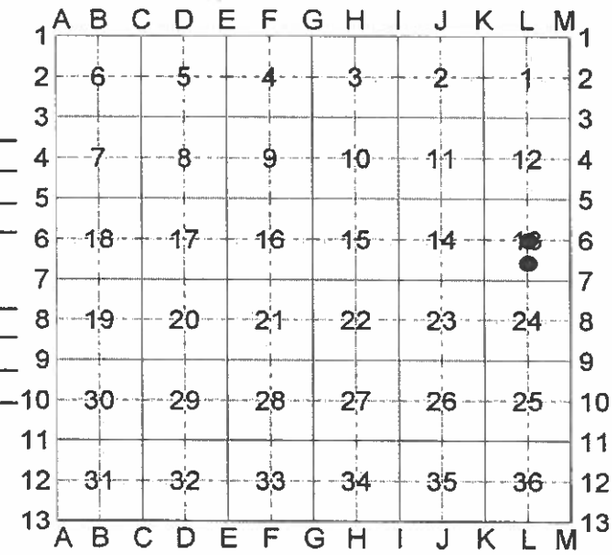

Original Public Land Survey Corner			Corner Code
S	T	R	
S	T	R	
S	T	R	
S	T	R	

Property Corner					Corner Code
a. S	13	T 44N	R 32W		L6 (GCDB 640440)
S		T	R		
b. S	13	T 44N	R 32W		12 (GCDB 640420)
S		T	R		

Part A. Corner History

a. Center of Section 13 T44N-R32W. Not previously monumented.

STATE OF MICHIGAN
STEPHAN J. SZYSZKOSKI
PROFESSIONAL SURVEYOR
No. 33986
LICENSED PROFESSIONAL SURVEYOR

b. Center-South 1/16 corner, Section 13 T44N-R32W. Not previously monumented.

Part B: Surveyor's Report on Perpetuation, Restoration, Reestablishment, or Monumentation of Corner

a. May 9 2018. Established the position for the corner at the intersection of straight lines connecting opposite 1/4 corners.

b. May 9 2018. Established the position for the corner midway and on a straight line between Quarter corner 1367.95' south and Center of Section 13 1367.95' north.

Part C: Field Evidence of Perpetuation or Monumentation of Corner

a. Set 1"IDx28" I.pipe with 4" alum. MDNR cap.
Set measuring nail with MDNR tag in the side of:

6" W.Spruce N12°E 9.8'	mrkd "C1/4 BT"
3" W.Spruce N44°E 19.55'	do
15" Poplar S15°E 14.35'	do
7" Maple S75°W 36.8'	do

Set sq'd cedar post adjacent.
E= 7903326.99 N= 159384.16

b. Set 1"IDx28" I.pipe with 4" alum. MDNR cap.
Set measuring nail with MDNR tag in the side of:

8" Cherry N40°E 36.75'	mrkd "1/16S BT"
5" Sugar S74°E 6.15'	do
8" Poplar S33°W 19.9'	do
12" Poplar N82°W 23.1'	do

Set sq'd cedar post adjacent.
E= 7903315.92 N= 158967.42

Bearings are magnetic. Coordinates are MCS83 in meters, NAD83(2011) Epoch 2010.00 datum.

Stephen J Szyszkoski 05/30/2018

Professional Surveyor's License No.: 33986

Prepared By: S.J. Szyszkoski for the Michigan Dept. of Natural Resources, 427 N. US41 Baraga, MI 49908