SURVEY & REMONUMENTATION COMMISSION

MAY 20 1997

MACKINAC COUNTY REMONUMENTATION CORNER

LAND CORNER RECORDATION CERTIFICATE
Filing Requirement of Act 74, Mich. P.A. 1970

For corners in MACKINAC (County)

	Located In:	Corner Code #
1. Public Land Survey	T 44N R 12W	M-9
	T____ R____	
	T____ R____	
	T____ R____	
2. Property Controlling	S____ T____ R____	
in Section	S____ T____ R____	
3. Miscellaneous	S____ T____ R____	
Property in Sec.	S____ T____ R____	

RECEIVED & FILED
DIANE FRANKOVICH
MACKINAC COUNTY REGISTER OF DEEDS
NOV 15 1996
AM PM
7|8|9|10|11|12|1|2|3|4|5|6
A

Register of Deeds Stamp & File Number

4. Lot No. _____ , Recorded Plat _____

5. Private Claims _____

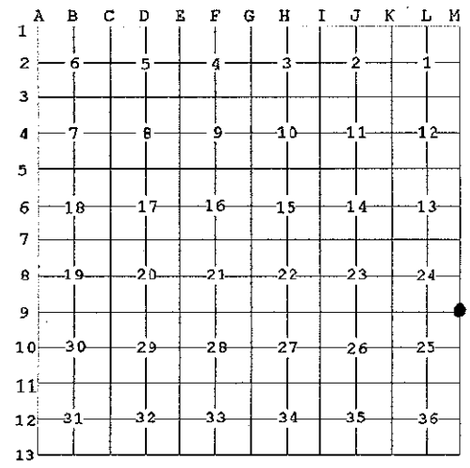

I, JAMES H. GRANGER, in a field survey on AUGUST 29, 19 96 do hereby state that under requirements of P.A. 74, Michigan P.A. of 1970, the corner points mentioned in lines 1 and 2 above were in conformance with regulations and rules therefore as required in the current manual of survey instructions of the United States Department of the Interior, Bureau of Land Management or by a decree of a Court of Law and /or that the corner points mentioned in lines 3, 4 and 5 above were in conformance with the rules of the Michigan Board of Land Surveyors or by a Decree of a Court of Law; established, re-established, monumented, recovered, found as expressed below:

NOTE: Not more than 2 corners, all in the same town and range, may be recorded on this certificate.

A. Description of original monument and accessories and/or subsequent restoration:

1841 - Original Survey W. Burt	Set wood post	14" Cedar N11°E 20 lks 24" Cedar N47°W 24 lks
1975 - Survey Thomas O'Brien # 21274	pk nail	
1975 - Survey Thomas O'Brien # 21274	pk nail	
1993 - LCRC Thomas Fabis # 31591	1/2" iron	
1995 - Survey John Ferguson # 24595	1/2" iron	

B. Description of corner evidence found and/or method applied in restoring or reestablishing corner:

Found 1/2" iron with cap #31591, three Fabis witnesses and four Ferguson witnesses.

ACCEPTED BY THE MACKINAC COUNTY SURVEY PEER GROUP AS THE OFFICIAL CORNER UNDER P.A. 345 OF 1990 AT A MEETING HELD ON 8-20-96

James H Granger

C. Description of monument for corner and accessories established to perpetuate locating the position of the corner:

Also corner A-9, T44N, R11W

Set 5/8" X 30" rebar with Remonumentation Cap

12" Ash	N27°W	72.71'	Fd. tag #31591
11" Cedar	S72°W	42.22'	Fd. tag #31591
12" Maple	S40°E	89.00'	Fd. tag #31591
12" Birch	S55°W	35.00'	Fd. nail

STATE OF MICHIGAN
JAMES H. GRANGER
PROFESSIONAL SURVEYOR
No. 16041
LICENSED PROFESSIONAL SURVEYOR

Signed by James H Granger

Date 10-10-96

Surveyor's Michigan License No. 16041

FORM APPROVED BY MICHIGAN STATE BOARD OF PROFESSIONAL SURVEYORS, JAN. 28, 1971
REVISED MAY 14, 1975
REVISED JAN., 1983
REVISED OCT., 1995

F 0103