SURVEY & REMONUMENTATION

FEB 2 6 1998

SECTION

CHEBOYGAN COUNTY REMONUMENTATION LAND CORNER RECORDATION CERTIFICATE

Filing Requirement of Act 74, Mich. P.A. 1970

RECEIVED FOR RECORD 12-18-97
at 11:09 O'Clock A M

Joanne Spray

CLERK/REGISTER
CHEBOYGAN COUNTY, MICHIGAN

Register of Deeds Stamp & File Number

For corners in Cheboygan (County)

	Located In:	Corner Code #
1. Public Land Survey	T36N R 3W	K-6
	T___ R___	
	T___ R___	
	T___ R___	
2. Property Controlling in Section	S___ T___ R___	
	S___ T___ R___	
3. Miscellaneous Property in Sec.	S___ T___ R___	
	S___ T___ R___	

4. Lot No. _____, Recorded Plat _____
5. Private Claims _____

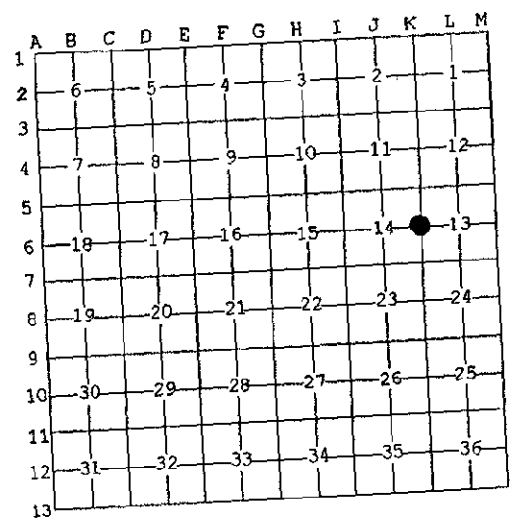

I, Brian K. Fullford, in a field survey on Sept 17, 1997 do hereby state that under requirements of P.A. 74, Michigan P.A. of 1970, the corner points mentioned in lines 1 and 2 above were in conformance with regulations and rules therefore as required in the current manual of survey instructions of the United States Department of the Interior, Bureau of Land Management or by a decree of a Court of Law and /or that the corner points mentioned in lines 3, 4 and 5 above were in conformance with the rules of the Michigan Board of Land Surveyors or by a Decree of a Court of Law; established, re-established, monumented, recovered, found as expressed below:

NOTE: Not more than 2 corners, all in the same town and range, may be recorded on this certificate.

A. Description of original monument and accessories and/or subsequent restoration:

G.L.O.
1855 Harvey Mellen
Intersected old 1/4 Sec. corner and reestablished the same
18" Y. Birch S 54° W 14 lks
6" Cedar S 53° E 10 lks

1974 Richard Bidstrup #11360
Found Iron
Liber 355, Page 394

1988 James Granger # 16041
Set 1/2" rod & cap #16041
12" Cedar N 78° E 2.52'
8" Cedar N 6° E 7.10'
4" Cedar N 44° W 10.08'
16" Cedar N 66° W 10.54'

1994 Richard Dunn #12020
Fnd 1/2" bar & cap #16041
14" Cedar N 79° E 2.52'
10" Cedar N 6° E 7.10'
6" Cedar N 44° W 10.08'
17" Cedar N 66° W 10.84'

B. Description of corner evidence found and/or method applied in restoring or reestablishing corner:

Found 1/2" rod & cap #16041, lying on ground, and 2 witnesses. Recovered C 1/4, East 1/4 corners, and irons placed by Richard Bidstrup's 1974 Survey to South.

CHEBOYGAN COUNTY
SEP 2 5 1997

LIBER 011 PAGE 13

C. Description of monument for corner and accessories established to perpetuate locating the position of the corner:

K-6 Set 5/8" rebar with remonumentation cap and is accepted as a careful and faithful perpetuation of the original corner.

10" Cedar N 6° E 6.92' Set Tag 41099
16" Cedar N 78° E 17.43' Set Tag 41099
1" Axle N 89° W 57.94'
7" Cedar N 47° W 9.78' Set Tag 41099

Wire fence line runs East & West

STATE OF MICHIGAN
BRIAN K. FULLFORD
PROFESSIONAL SURVEYOR
No. 41099
LICENSED PROFESSIONAL SURVEYOR

Signed by B. K. Fullford Date 11/21/97

Surveyor's Michigan License No. 41099

FORM APPROVED BY MICHIGAN STATE BOARD OF PROFESSIONAL SURVEYORS, JAN. 28, 1971
REVISED MAY 14,1975
REVISED JAN., 1983
REVISED OCT., 1995