

# SURVEY & REMONUMENTATION

CHEBOYGAN COUNTY REMONUMENTATION CORNER

JAN 23 1996

## LAND CORNER RECORDATION CERTIFICATE

COMMISSION Filing Requirement of Act 74, Mich. P.A. 1970

For corners in

CHEBOYGAN

(County)

Burt Township

1. Public Land Survey

Located In:

Corner Code ##

T 36N R 3W

M-7

T R

T R

T R

T R

2. Property Controlling in Section

S T R

S T R

3. Miscellaneous

S T R

Property in Sec.

S T R

4. Lot No. , Recorded Plat

5. Private Claims

RECEIVED FOR RECORD

95 SEP 18 AM 10:15

*James Spray*

CLERK/REGISTER  
CHEBOYGAN COUNTY, MICHIGAN

Register of Deeds Stamp & File Number

I, Ronald Bischer, in a field survey on July 6, 19 95, do hereby certify that under requirements of P.A. 74, Michigan P.A. of 1970, the corner points mentioned in lines 1 and 2 above were in conformance with regulations and rules therefore as required in the current manual of survey instructions of the United States Department of the Interior, Bureau of Land Management or by a decree of a Court of Law and/or that the corner points mentioned in lines 3, 4 and 5 above were in conformance with the rules of the Michigan Board of Land Surveyors or by a Decree of a Court of Law; established, re-established, monumented, re-monumented, recovered, found as expressed below:

NOTE: Not more than 4 corners, all in the same town and range, may be recorded on this certificate.

A. Description of original monument and accessories and/or subsequent restoration:

1840 Original Survey

John Mullett

Set wood post

20" Pine S75°W 4 lks

16" Pine N16°W 31 lks

N41°E 90.86' Power pole

S78°W 55.31' 24" Stump

N30°W 100.54' 5" Oak

1979 Survey

Ronald R. Bischer #22428

Found 3/4" Bar in pipe

S68°E 97.64' 4" White Pine

N28°W 100.75' 7" Oak

N42°E 91.22' Power pole

B. Description of corner evidence found and/or method applied in restoring or reestablishing corner:

Found 3/4" Iron bolt with Nut on top - 36" long. Replaced with


5/8" Rod and Cheboygan County Remonumentation cap.

N40°E 91.02' Power pole

S72°E 97.45' 8" White pine

N30°W 100.70' 12" White Oak

West 32.80' 1" Pipe

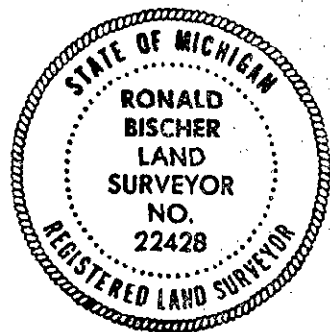

LIBER 010 PAGE 113

- Description of monument for corner and accessories established to perpetuate locating the position of the corner:

5/8" Rod with Cheboygan County Remonumentation cap

N40°E 91.02' Power pole

S72°E 97.45' 8" White pine

N30°W 100.70' 12" White Oak

S34°W 83.09' 13" Sawtooth Aspen

West 32.80' 1" Pipe

Nails with witness tag #22428 used.

*Maurice A. [Signature]*

DEC 11 1995

Cheboygan County  
Re-Monumentation

igned by Ronald R. Bischer

Date July 28, 1995

veyor's Michigan License No. 22428