E-1/E-13 T42N, R29W

# LAND CORNER RECORDATION CERTIFICATE
**Filing Requirement of Act 74, Mich. P.A. 1970**

RECORDED
1999 NOV 30 PM 3:31
REGISTER OF DEEDS
DICKINSON COUNTY
IRON MOUNTAIN, MI 49801

For corners in

DICKINSON (County)
NORWAY TOWNSHIP

Located In: Corner Code #

1. Public Land Survey — T 41 N R 29 W E-1; T 41 N R 29W E-3; T___ R___; T___ R___
2. Property Controlling in Section — S___ T___ R___; S___ T___ R___
3. Miscellaneous Property in Sec. — S___ T___ R___; S___ T___ R___

SURVEY & REMONUMENTATION
MAR 24 2000

Register of Deeds Stamp & File Number

4. Lot No. _____, Recorded Plat _____
5. Private Claims _____

SECTION

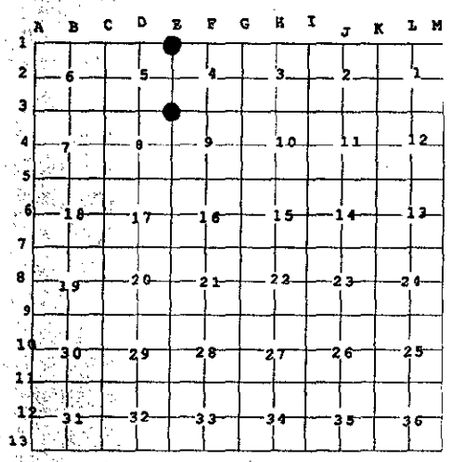


I, JAMES H. MOORE, in a field survey on AUGUST 19, 19 99 do hereby state that under requirements of P.A. 74, Michigan P.A. of 1970, the corner points mentioned in lines 1 and 2 above were in conformance with regulations and rules therefore as required in the current manual of survey instructions of the United States Department of the Interior, Bureau of Land Management or by a decree of a Court of Law and /or that the corner points mentioned in lines 3, 4 and 5 above were in conformance with the rules of the Michigan Board of Land Surveyors or by a Decree of a Court of Law; established, re-established, monumented, recovered, found as expressed below:

**NOTE: Not more than 2 corners, all in the same town and range, may be recorded on this certificate.**

A. Description of original monument and accessories and/or subsequent restoration:

E-1 CORNER COMMON TO SECTIONS 4-5 (T41N, R29W) AND SECTIONS 32-33 (T42N, R29W)
CEDAR POST BY AUSTIN BURT, D.S. 1847

| | | |
|---|---|---|
| SPRUCE 9" | N 28° E | 28 LINKS |
| CEDAR 12" | N 38° W | 46 LINKS |

E-3 CORNER COMMON TO SECTIONS 4-5-8-9
CEDAR POST BY JOHN BURT, D.S. 1849

| | | |
|---|---|---|
| WHITE BIRCH 16" | S 37° W | 28 LINKS |
| CEDAR 14" | N 38° E | 30 LINKS |

B. Description of corner evidence found and/or method applied in restoring or reestablishing corner:

E-1 FOUND 1" PIPE WITH A 4" BRASS CAP, SET BY DEAN DE LA MATER R.L.S. #13030.

1951 BEARING TREES

| | | |
|---|---|---|
| 10" CEDAR | S 83° E | 15 LINKS |
| 10" CEDAR | S 18° E | 31 LINKS |

E-3 FOUND 3" BRASS CAP IN 6" DIAMETER CONCRETE MONUMENT, SET BY EDWARD KAZIANKA P.S. 14765.
FOUND TWO EXISTING BEARING TREES

1966 BEARING TREES

| | | |
|---|---|---|
| 12" WHITE PINE | N 56° E | 37 ½ LINKS |
| 6" MAPLE | N 28° W | 19 LINKS |
| 9" MAPLE | S 25° W | 27 ½ LINKS |

C. Description of monument for corner and accessories established to perpetuate locating the position of the corner:

E-1 FOUND ABOVE DESCRIBED MONUMENT IN PLACE
NEW WITNESSES

| | | | | |
|---|---|---|---|---|
| 8" CEDAR | S 67° E | (M.B.) | 75.10' | NAIL/TAG |
| 10" CEDAR | N 77° E | (M.B.) | 69.84' | NAIL/TAG |
| 11" CEDAR | S 85° W | (M.B.) | 74.42' | NAIL/TAG |
| 8" CEDAR | N 44° W | (M.B.) | 93.68' | NAIL/TAG |
| CARSONITE MARKER | | NORTH | 0.85' | |

E-3 FOUND ABOVE DESCRIBED MONUMENT IN PLACE
NEW WITNESSES

| | | | | |
|---|---|---|---|---|
| 12" WHITE BIRCH | S 68° E | (M.B.) | 26.80' | NAIL/TAG |
| 8" MAPLE | N 75° E | (M.B.) | 19.52' | NAIL/TAG |
| 9" MAPLE | S 29° E | (M.B.) | 41.08' | NAIL/TAG |
| 9" MAPLE | S 80° W | (M.B.) | 17.23' | NAIL/TAG |
| CARSONITE MARKER | | WEST | 1.00' | |

Signed by _____ Date 11-8-99
Surveyor's Michigan License No. 28423

STATE OF MICHIGAN
JAMES H. MOORE
LAND SURVEYOR
No. 28423
LICENSED LAND SURVEYOR

FILED WITH THE COUNTY AS THE OFFICIAL CORNER UNDER MICHIGAN PUBLIC ACT 345 OF 1990 AT A MEETING HELD ON 11-23-99
COUNTY REPRESENTATIVE

FORM APPROVED BY, MICHIGAN STATE BOARD OF PROFESSIONAL SURVEYORS, JAN. 28, 1971
REVISED MAY 14,1975
REVISED JAN., 1983
REVISED OCT., 1995

Liber 3 PAGE 4