SURVEY & REMONUMENTATION

MAR 0 3 1998

KENT COUNTY REMONUMENTATION

"other" code #4

SECTION

LAND CORNER RECORDATION CERTIFICATE
Filing Requirement of Act 74, Mich. P.A. 1970

For corners in KENT COUNTY (County)

STATE OF MICHIGAN COUNTY OF KENT RECEIVED FOR RECORD 97 OCT 14 AM 10: 30 REG. OF DEEDS

10054

Register of Deeds Stamp & File Number

	Located In:	Corner Code #
1. Public Land Survey	T___ R___	
	T___ R___	
	T___ R___	
	T___ R___	
2. Property Controlling in Section	S 23 T 5N R 9W	Wit. Mon. on E-W 1/4 line
3. Miscellaneous Property in Sec.	S___ T___ R___	
	S___ T___ R___	
	S___ T___ R___	

4. Lot No. _____, Recorded Plat _____
5. Private Claims _____

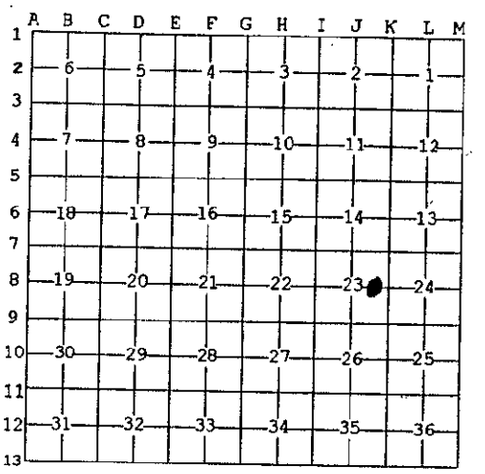

I, Kirk Breitels, in a field survey on July 23, 19 97 do hereby state that under requirements of P.A. 74, Michigan P.A. of 1970, the corner points mentioned in lines 1 and 2 above were in conformance with regulations and rules therefore as required in the current manual of survey instructions of the United States Department of the Interior, Bureau of Land Management or by a decree of a Court of Law and /or that the corner points mentioned in lines 3, 4 and 5 above were in conformance with the rules of the Michigan Board of Land Surveyors or by a Decree of a Court of Law; established, re-established, monumented, recovered, found as expressed below:

NOTE: Not more than 2 corners, all in the same town and range, may be recorded on this certificate.

A. Description of original monument and accessories and/or subsequent restoration:

No Information - Not Set

See LCRC # 10053 for Central 1/4 corner (J-8) of Sec. 23

P.A. 345 1990 KENT COUNTY
PEER APPROVED 8/28/97
CHAIRMAN [signature]

B. Description of corner evidence found and/or method applied in restoring or reestablishing corner:

Established point on E-W 1/4 line 330.00' East of the C 1/4 corner. This point is also a property corner per descriptions.

This point is on remains of fence to North ± and is 5'± North of remains of fence to East.

The selected location is accepted by me and is generally accepted by professional surveyors as the best available evidence of the corner.

C. Description of monument for corner and accessories established to perpetuate locating the position of the corner:

Set Harrison Monument with witness cap at point described above.

Nail & KC Remon. tag S. side 8" thorn tree	S70°E	21.29'
Nail & KC Remon. tag N. side 30" Cherry	N80°E	42.02'
Nail & KC Remon. tag SE side 6" Hickory	N60°E	42.00'
Nail & KC Remon. tag W. side 10" Cherry	N10°E	35.03'

STATE OF MICHIGAN KIRK BREITELS LAND SURVEYOR NO 30077 LICENSED LAND SURVEYOR

Signed by [signature]

Surveyor's Michigan License No. 30077

Date 9/5/97

FORM APPROVED BY MICHIGAN STATE BOARD OF PROFESSIONAL SURVEYORS, JAN. 28, 1971
REVISED MAY 14,1975
REVISED JAN., 1983
REVISED OCT., 1985