SURVEY & REMONUMENTATION

APR 27 1995

COMMISSION

STATE OF MICHIGAN
COUNTY OF KALAMAZOO
RECEIVED FOR RECORD
'94 SEP 21 AM 10 21
CLERK-REGISTER

LIBER 1 PG 1167
Register of Deeds Stamp & File Number

LAND CORNER RECORDATION CERTIFICATE

Filing Requirement of Act 74, Mich. P.A. 1970

For corners in KALAMAZOO (County)

	Located In:	Corner Code #
Alamo Township 1. Public Land Survey	T 1 S R 12 W	K-9
	T ___ R ___	
	T ___ R ___	
	T ___ R ___	
2. Property Controlling	S ___ T ___ R ___	
in Section	S ___ T ___ R ___	
3. Miscellaneous	S ___ T ___ R ___	
Property in Sec.	S ___ T ___ R ___	

4. Lot No. _____, Recorded Plat _____
5. Private Claims _____

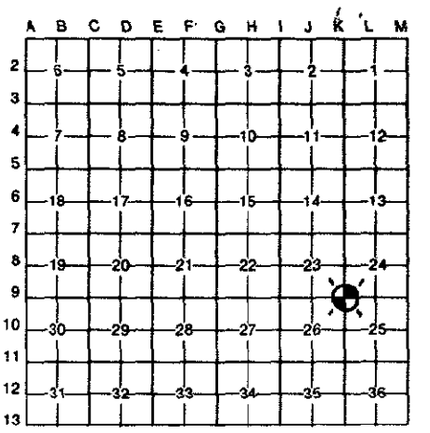

I, Robert E. Snell, in a field survey on May 4, 19 94, do hereby certify that under requirements of P.A. 74, Michigan P.A. of 1970, the corner points mentioned in lines 1 and 2 above were in conformance with regulations and rules therefore as required in the current manual of survey instructions of the United States Department of the Interior, Bureau of Land Management or by a decree of a Court of Law and/or that the corner points mentioned in lines 3, 4 and 5 above were in conformance with the rules of the Michigan Board of Land Surveyors or by a Decree of a Court of Law; established, re-established, monumented, re-monumented, recovered, found as expressed below:

NOTE: Not more than 4 corners, all in the same town and range, may be recorded on this certificate.

A. Description of original monument and accessories and/or subsequent restoration:

1829 - U. S. Government Survey-Set Post, Corner to Sections 23, 24, 25 and 26
Yellow Oak 5" South 71° East 29 Lks
White Oak 19" South 44° West 104 Lks

1869 - F. Hodgeman County Surveyor-Section Corner stone set by Stimson.
Yellow Oak 12" North 80°± West 1.61 Lks

1920 - Kalamazoo County Road Commission-Iron Rod. No accessories.

1954 - Ingersoll Watson and McMachen-Set Northwest Corner Section 25
Oak 24" North 33°-15' West 66.5' Elm 36" South 45° West 31.7'
Oak 42" North 84° West 106.3'

B. Description of corner evidence found and/or method applied in restoring or reestablishing corner:

1994 - Found iron rod in Monument Box. Original monument destroyed or lost. No accessories found. Iron set measured 2,640.25'(1955 Ingersoll Watson and McMachen) West of North ¼ Post of Section 25 (2639.50', 1978 Wilkins & Wheaton Engineering Company). From West ¼ Post to Northwest Corner Section 25 measured 2,639.04' (1954 Ingersoll Watson and McMachen), from West ¼ Post to Southwest Corner Section 24 measured 2635.38' (1978 Wilkins and Wheaton Engineering Company) and 1312.95 (cal. Ingersoll Watson and McMachen, 1990) East of 1/8 Post on South Section Line of Section 23. Excavated to 7' North, 9½' West, 12' South and 5' to East and found no evidence of original corner.

RATIFIED R.E.S.
BY KALAMAZOO COUNTY
REMONUMENTATION
PEER GROUP 7/21/94

C. Description of monument for corner and accessories established to perpetuate locating the position of the corner:

K-9 Corner to Sections 23, 24, 25 and 26, T. 1 S., R. 12 W., ratified by the Kalamazoo County Remonumentation Program Peer Group July 21, 1994. Found iron (½" x 2') in Monument Box as called for in 1954 survey by Ingersoll, Watson and McMachen and is accepted as a careful and faithful re-establishment of the position of the original corner. Removed iron and placed a 20" Harrison Monument inside Monument Box on August 8, 1994.

Existing Nail/Tab in East Side	36" Maple	North 30° West 66.0'	Trav.CL Rd to East
Existing Nail/Tab in East Side	Tel.Pole	South 50° West 54.97'	South 2.5'
Existing Nail/Tab	15" Sasafras	North 10° East 39.59'	Trav.CL Ravine Rd
Nail	Sasafras	South 04° West 57.37'	West 10.5'

Signed by Robert E. Snell Date 9-19-94

Surveyor's Michigan License No. 9734

FORM APPROVED BY MICHIGAN STATE BOARD OF LAND SURVEYORS, JAN. 28, 1971
REVISED MAY 14, 1975
REVISED JAN., 1983