

LAND CORNER RECORDATION CERTIFICATE
Filing Requirement of Act 74, Mich. P.A. 1970

For corners in

LIVINGSTON
 (County)

Located In:

Corner Code J-07

1. Public Land Survey

T 3N R 6E

J-07

T _____ R _____

T _____ R _____

T _____ R _____

2. Property Controlling
in Section

S _____ T _____ R _____

S _____ T _____ R _____

3. Miscellaneous
Property in Sec.

S _____ T _____ R _____

S _____ T _____ R _____

4. Lot No. _____, Recorded Plat _____

5. Private Claims _____

NANCY HAVILAND
 REGISTER OF DEEDS
 LIVINGSTON COUNTY, MI
 48843

OCT 7 11 09 AM '96

FILED

L.S.C.# 555M

Register of Deeds Stamp & File Number

I, Jack K. Smith, in a field survey on June 20, 19 96,
 do hereby certify that under requirements of P.A. 74, Michigan P.A. of 1970, the corner points mentioned
 in lines 1 and 2 above were in conformance with regulations and rules therefore as required in the
 current manual of survey instructions of the United States Department of the Interior, Bureau of Land
 Management or by a decree of a Court of Law and/or that the corner points mentioned in lines 3, 4 and 5
 above were in conformance with the rules of the Michigan Board of Land Surveyors or by a Decree of a
 Court of Law; established, re-established, monumented, re-monumented, recovered, found as
 expressed below:

**NOTE: Not more than 4 corners, all in the same town and range, may be recorded
 on this certificate.**

A. Description of original monument and accessories and/or subsequent restoration:

J-07 The South 1/4 Corner of Section 14, Hartland Township was set by the
 GLO in 1823 by Sylvester Sibley.

The original witnesses are:

W Oak 14" N79 1/2°W 67 lk (44.2')

W Oak 12" S47 1/2°W 61 lk (40.3')

**NOTE: NONE OF THE ORIGINAL WITNESSES COULD BE FOUND OR PERPETUATED.
 SEE THE BACK OF THIS SHEET FOR ADDITIONAL HISTORICAL DATA.**

B. Description of corner evidence found and/or method applied in restoring or reestablishing corner:

J-07 Found 1/2" iron on the centerline of Dunham Road.



C. Description of monument for corner and accessories established to perpetuate locating the position of the corner:

J-07 South 1/4 Corner, Section 14, T3N, R6E

Set 30" x 1 1/4" iron pipe with 6" x 1 1/4" break-off and brass cap marked
as "Livingston County Monument Corner".

N02°W	Set nail and tag in E side 20" Ash	23.59'
S05°W	Set nail and tag in W side 12" Ash	31.69'
S60°W	Set nail and tag in N side 24" Hickory	87.50'
S50°E	Set nail and tag in NE side 14" Ash	63.27'

Signed by [Signature] Date June 20, 1996Surveyor's Michigan License No. 35999

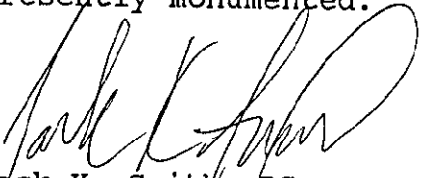
FORM APPROVED BY MICHIGAN STATE BOARD OF LAND SURVEYORS, JAN 28, 1971
 REVISED MAY 14, 1975
 REVISED JAN 1, 1983

P.A. 345 1980, APPROVED BY LIVINGSTON COUNTY
FEER GROUP ON 4-17-96, CO. REP JED

April 12, 1996

J-07 T3N - R6E: SOUTH 1/4 CORNER, SECTION 14, HARTLAND TOWNSHIP

Found a 1/2" iron on the centerline of Dunham Road about 80 feet westerly of a creek crossing. The corner was originally recorded as being set by S. Sibley in 1823. Witnesses for this corner can be traced directly back to 1966 Garlock witnesses and no other location has been reported for the corner. Measures compare well with the exception of a distance which disagrees by 2-3 feet by Munsell. There is light occupation to the south and a creek to the north. This corner is slightly masked to the northwest and south but should not pose much of a problem for GPS usage. Based on the apparent perpetuation of the corner from 1966 to the present, and the apparent common usage of this corner, I recommend accepting J-07, the South 1/4 Corner of Section 14, at the location as is presently monumented.


Jack K. Smith, PS
Desine Inc.

