

CONTINUED

■ **For corners in**

<u>Manistee</u> (County)	Located In:	Corner Code #
1. Public Land Survey	T <u>22N</u> R <u>17W</u>	<u>J-13 MC</u>
	T <u> </u> R <u> </u>	<u>East of South</u>
	T <u> </u> R <u> </u>	<u>1/4 Corner of</u>
	T <u> </u> R <u> </u>	<u>Section 35</u>
2. Property Controlling in Section	S <u> </u> T <u> </u> R <u> </u>	
	S <u> </u> T <u>21N</u> R <u>17W</u>	<u>J-01 MC</u>
3. Miscellaneous Property in Sec.	S <u> </u> T <u> </u> R <u> </u>	<u>#7</u>
	S <u> </u> T <u> </u> R <u> </u>	

REGISTER OF DEEDS

Register of Deaths Stamp & File Number

4. Lot No. _____, Recorded Plat _____

5. Private Claims _____

Anthony M. Slawinski, in a field survey on July 29, 19 97 do hereby state that under requirements of P.A. 74, Michigan P.A. of 1970, the corner points mentioned in lines 1 and 2 above were in conformance with regulations and rules therefore as required in the current manual of survey instructions of the United States Department of the Interior, Bureau of Land Management or by a decree of a Court of Law and /or that the corner points mentioned in lines 3, 4 and 5 above were in conformance with the rules of the Michigan Board of Land Surveyors or by a Decree of a Court of Law; established, re-established, monumented, recovered, found as expressed below:

NOTE: Not more than 2 corners, all in the same town and range, may be recorded on this certificate.

A. Description of original monument and accessories and/or subsequent restoration:
 J-13 Meander corner East of the South 1/4 Corner of Section 35, T22N., R17W.

Set by John Brink in 1838

14.18 chains, Int. East Margin of Lake Michigan, Set Post

1. Yellow Pine 13" N 64 ½° E 20 links (Gone)
2. Yellow Pine 11" S 22° E 78 links (Gone)

B. Description of corner evidence found and/or method applied in restoring or reestablishing corner:

J-13 Meander corner East of the South ¼ Corner of Section 35, T22N., R17W.

Established the South line of Section 35 using the Southeast Section Corner of Section 35 and the Northwest Corner of The Dunes Plat. Then measured the GLO distance West from the Southeast Section corner of Section 35, along the established South line, and set the monument.

Also referenced:

GLO Field notes by John Brink (1838), Book 1, Page 417

Survey by Zwar (1996)

Survey by Slawinski (1988)

The Dunes Plat (July 23, 1990), Liber 534, Pages 304 through 310

Manistee Industrial Park Plat (May 22, 1990) Liber 6, Pages 56-58

C. Description of monument for corner and accessories established to perpetuate locating the position of the corner:

J-13 Meander corner East of the South ¼ Corner of Section 35, T22N., R17W.

On July 29, 1997, I installed a Manistee County Monument, flush to the ground and surrounded by rocks, at the same 14.18 chains distance West of the Southeast section corner of section 35, T22N., R17W. as a careful and faithful re-establishment of the position of the original corner, and witnessed by:

3. N 76° E 71.00' 18" Oak (Spike in the Southeast side)
4. N 41° E 59.82' 4" Aspen (Spike in the Southeast side)
5. S 68° E 57.40' 4" Oak (Spike in the Northeast side)
6. S 88° E 39.49' Concrete Monument (Northwest Corner of The Dunes Plat)


Approximately 30' from Lake Michigan


Surveyor's Michigan License No. 13597

Cover J - L3 mc ratified by the Manistee County Peer Group according to the county plan adopted pursuant to P.A. 345 of 1990, as amended, (being the State Survey and Remonument Act, MCL 54.261 et. seq.). Date of Peer Review: Arthur M. Stanley

OCT 7 1997

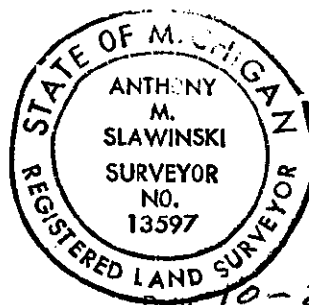

Date 10-2-97