LAND CORNER RECORDATION CERTIFICATE

Filing Requirement of Act 74, Mich. P.A. 1970

For corners in MIDLAND (County)

	Located In:	Corner Code ##
1. Public Land Survey	T 15N R 1W	6-9,6-10
	T ___ R ___	
	T ___ R ___	
	T ___ R ___	
2. Property Controlling	S 27 T ___ R ___	8
in Section	S ___ T ___ R ___	
3. Miscellaneous	S ___ T ___ R ___	
Property in Sec.	S ___ T ___ R ___	

Register of Deeds Stamp & File Number

4. Lot No. _____ , Recorded Plat _____
5. Private Claims _____

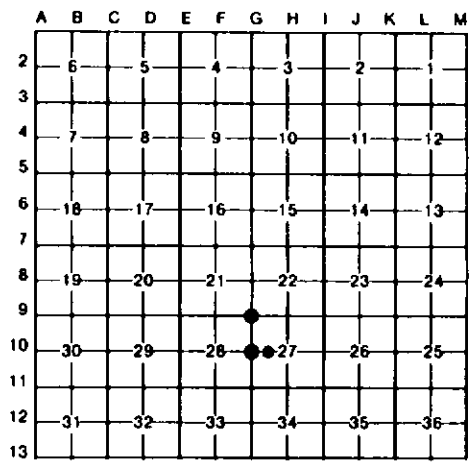

I, CARL KIISKILA, in a field survey on MAY 21, 19 96, do hereby certify that under requirements of P.A. 74, Michigan P.A. of 1970, the corner points mentioned in lines 1 and 2 above were in conformance with regulations and rules therefore as required in the current manual of survey instructions of the United States Department of the Interior, Bureau of Land Management or by a decree of a Court of Law and/or that the corner points mentioned in lines 3, 4 and 5 above were in conformance with the rules of the Michigan Board of Land Surveyors or by a Decree of a Court of Law; established, re-established, monumented, re-monumented, recovered, found as expressed below:

NOTE: Not more than 4 corners, all in the same town and range, may be recorded on this certificate.

A. Description of original monument and accessories and/or subsequent restoration:

6-9 6-10 8

(NO EVIDENCE OF G.L.O. CORNER, B.T'S, LINE TREES & TOPOGRAPHY, AS CALLED OUT IN THE G.L.O. LINE NOTES; UNLESS NOTED IN ITEM 'B' BELOW.)

B. Description of corner evidence found and/or method applied in restoring or reestablishing corner:

6-9

FOUND 5/8" BOAT SPIKE IN MON BOX FOR THE NW COR OF SEC 27. COR IS AT INTERSECTION N-S-E-W BLACK TOP ROADS. COR FITS CERT OF SURVEY BY D. LEDY PS #21575, LIBER 5, PAGE 180 IN THE SW1/4 OF THE NW1/4 OF SEC 27.

6-10

FOUND RR SPIKE FOR W1/4 COR OF SEC 27. COR FITS SEVERAL CERT OF SURVEYS BY D. LEDY IN SEC 27 & 28. OLD FENCE TO EAST IS 3'+/- SOUTH.

8

ESTABLISHED THE NW COR OF THE NE1/4 OF THE SW1/4 OF SEC 27 PER STANDARD BLM INSTRUCTIONS. FENCE COR IS 4' WEST (FN W & S). CTR OF IRREGULAR WINDING E-W DITCH IS 48'+/- NORTH.

C. Description of monument for corner and accessories established to perpetuate locating the position of the corner:

6-9

FOUND 5/8" BOAT SPK IN MON BOX
*POWER POLE N45°W 51.65'
CTR 6" X 6" METAL TEL RISER N60°E 61.3'
**GUY POLE S45°E 51.00'
4" RED PINE S60°W 82.94'

*= PS, J.JONES #19838 1980 WIT
**= WIT BY D. LEDY PS #21575

6-10

FOUND RR SPK, FLUSH, IN CTR N-S BLACK TOP ROAD.
*POWER POLE WEST 39.24'
*POWER POLE N35°E 63.03'
*COR FN POST EAST 33.35'
*TOP CTR OF FIRE HYDRANT S50°W 45.72'
FD D. LEDY 1/2" REROD EAST 33.05'

*=1993 WIT BY D. LEDY PS

8

SET 5/8" X 34" REROD W/PS CAP & SET CARSONITE POST W/LOC TAG
14" MAPLE N50°W 5.18'
14" WHITE OAK N70°E 24.60'
17" MAPLE S20°E 24.87'
10" MAPLE S70°W 8.94'

STATE OF MICHIGAN
CARL KIISKILA
LAND SURVEYOR
No. 33981
LICENSED LAND SURVEYOR

Signed by Carl T. Kiiskila Date 6-20-96

Surveyor's Michigan License No. 33981

FORM APPROVED BY MICHIGAN STATE BOARD OF LAND SURVEYORS, JAN. 28, 1971
REVISED MAY 14, 1975
REVISED JAN., 1983