LAND CORNER RECORDATION CERTIFICATE

Filing Requirement of Act 74, Mich. P.A. 1970

For corners in MIDLAND (County)

	Located In:	Corner Code #
1. Public Land Survey	T 15N R 1W	H-9,H-10
	T ___ R ___	I-9
	T ___ R ___	
	T ___ R ___	
2. Property Controlling	S 27 T ___ R ___	13
in Section	S ___ T ___ R ___	
3. Miscellaneous	S ___ T ___ R ___	
Property in Sec.	S ___ T ___ R ___	

Register of Deeds Stamp & File Number

4. Lot No. _____ , Recorded Plat _____
5. Private Claims _____

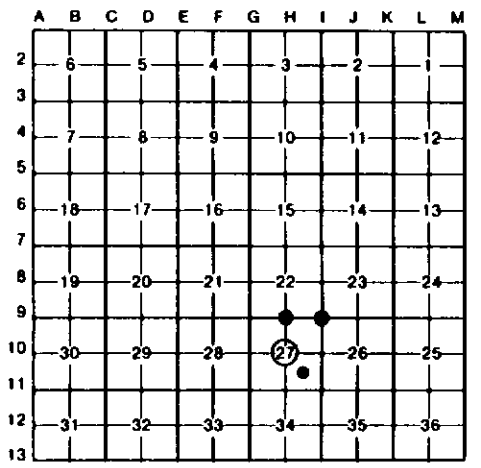

I, CARL KIISKILA, in a field survey on MAY 21, 19 96, do hereby certify that under requirements of P.A. 74, Michigan P.A. of 1970, the corner points mentioned in lines 1 and 2 above were in conformance with regulations and rules therefore as required in the current manual of survey instructions of the United States Department of the Interior, Bureau of Land Management or by a decree of a Court of Law and/or that the corner points mentioned in lines 3, 4 and 5 above were in conformance with the rules of the Michigan Board of Land Surveyors or by a Decree of a Court of Law; established, re-established, monumented, re-monumented, recovered, found as expressed below:

NOTE: Not more than 4 corners, all in the same town and range, may be recorded on this certificate.

A. Description of original monument and accessories and/or subsequent restoration:

H-9 H-10 I-9

(NO EVIDENCE OF G.L.O. CORNER, B.T'S, LINE TREES & TOPOGRAPHY, AS CALLED OUT IN THE G.L.O. LINE NOTES; UNLESS NOTED IN ITEM "B" BELOW.)

B. Description of corner evidence found and/or method applied in restoring or reestablishing corner:

H-9
FOUND 3/4" PIPE IN APPROX CTR E-W BLACK TOP ROAD FOR N1/4 COR SEC 27.

H-10
ESTABLISHED THE CENTER OF S-27 AT INTER. OF 1/4 LINES. CORNER FALLS ON SLOPE OF N-S, 6' DEEP, DRAINAGE DITCH. CTR OF DITCH IS 6' EAST AND TOP OF W'LY BANK IS 5' WEST. CTR OF GAS LINE OPENING, NW-SE, IS 4' NNE.

I-9
FD 3/4" PIPE 3' WEST OF INTER. OF B.TOP ROADS. N-S-E-W, FOR NE COR. S-27.

13
ESTABLISHED THE CTR OF SE1/4 OF S-27 PER STANDARD BLM INSTRUCTIONS. CORNER FALLS IN LOW WET AREA WITH 3" OF WATER & MUD.

C. Description of monument for corner and accessories established to perpetuate locating the position of the corner:

H-9
FOUND 3/4" PIPE.

*POWER POLE	N45°W	54.16'
14" W. PINE	N40°E	89.72'
*18" SWP W. OAK	S55°E	99.00'
TOP CTR FIRE HYD	S55°W	52.80'
FD 2" PIPE (13" OUT OF GRD) & CRESOTE POST	S17°E	34.43'

H-10
SET 5/8"X 34" REROD W/PS CAP AND CARSONITE POST W/LOC. TAG.

6" ASH	N25°W	54.10'
7" ELM	N85°E	57.48'
3" ELM	S25°W	26.15'
20" MAPLE	S80°W	57.56'

I-9
FD 3/4" PIPE.

*POWER POLE	N45°W	54.43'
8"SCOTCH PINE	N50°E	69.52'
*POWER POLE	S55°E	54.93'
*POWER POLE	S25°W	84.66'

13
SET 1"X 72" PIPE W/PS CAP AND CARSONITE POST W/LOC TAG.

17" R.PINE	N20°W	35.71'
3" MAPLE	N30°E	27.70'
15" R.PINE	S05°E	28.88'
7" TW. MAPLE	S70°W	40.52'

*= 1978 WIT BY J. SCHAFER PS

* = PS. T.MULLER 1987 WIT.

Signed by Carl T. Kiiskila Date 6-20-96

Surveyor's Michigan License No. 33981

FORM APPROVED BY MICHIGAN STATE BOARD OF LAND SURVEYORS, JAN. 28, 1971
REVISED MAY 14, 1975
REVISED JAN., 1983