SURVEY & REMONUMENTATION

APR 0 4 1996

COMMISSION

L1871 Pg. 637

A1747

STATE OF MICHIGAN
COUNTY OF MUSKEGON
RECEIVED FOR RECORD
1995 DEC 18 PM 4:17

Register of Deeds Stamp & File Number

LAND CORNER RECORDATION CERTIFICATE

Filing Requirement of Act 74, Mich. P.A. 1970

For corners in **Muskegon** (County)

	Located In:	Corner Code #
1. Public Land Survey	T 11N R 17W	G-11
	T ____ R ____	
	T ____ R ____	
	T ____ R ____	
2. Property Controlling	S ____ T ____ R ____	
in Section	S ____ T ____ R ____	
3. Miscellaneous	S ____ T ____ R ____	
Property in Sec.	S ____ T ____ R ____	

4. Lot No. _____, Recorded Plat _____
5. Private Claims _____

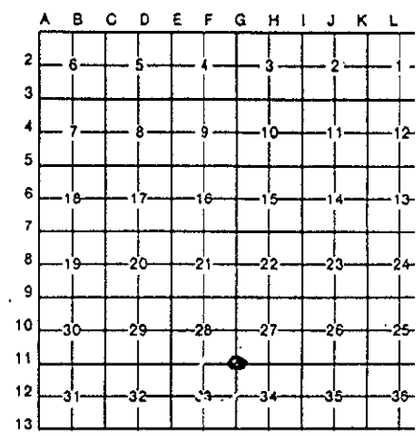

I, Stephen V. Vallier, P.S., in a field survey on November 6, 19 95, do hereby certify that under requirements of P.A. 74, Michigan P.A. of 1970, the corner points mentioned in lines 1 and 2 above were in conformance with regulations and rules therefore as required in the current manual of survey instructions of the United States Department of the Interior, Bureau of Land Management or by a decree of a Court of Law and/or that the corner points mentioned in lines 3, 4 and 5 above were in conformance with the rules of the Michigan Board of Land Surveyors or by a Decree of a Court of Law; established, re-established, monumented, re-monumented, recovered, found as expressed below:

NOTE: Not more than 4 corners, all in the same town and range, may be recorded on this certificate.

A. Description of original monument and accessories and/or subsequent restoration:

1837 GLO set corner	S 02 deg. W	37 Links	10" Black Oak
	N 18 deg. E	66 Links	8" White Oak
1950's MCRC - Iron			
(see Exhibit "A")			

B. Description of corner evidence found and/or method applied in restoring or reestablishing corner:

Found 4" x 30" Cast Iron Monument with County Survey Cap. Checks witnesses from Section "A".

POSITION OF SAID RECORDED CORNER REVIEWED & RATIFIED BY MUSKEGON COUNTY PEER GROUP IN ACCORDANCE WITH P.A. 345, OF 1990

Nov. 13, 1995

C. Description of monument for corner and accessories established to perpetuate locating the position of the corner:

Found 1/2" Iron Rod in Monument Box. Reset 4" x 30" Cast Iron Monument with County Survey Cap. (Record LCRC Liber 1478 Page 507)

N 52 deg. W	44.73'	Light Pole (found nail)
N 02 deg. W	30.94'	16" Oak (nail)
N 55 deg. E	42.55'	16" Oak (nail)
N 67 deg. E	79.00'	Twin 14 - 20" Oak (nail)
S 38 deg. E	54.86'	10" Pine (nail)
S 22 deg. W	78.40'	40" Oak (nail)

STATE OF MICHIGAN
STEPHEN VALLIER
Land Surveyor
No. 28428
LICENSED LAND SURVEYOR

Signed by Stephen V. Vallier Date Dec 15, 1995

Surveyor's Michigan License No. 28428

FORM APPROVED BY MICHIGAN STATE BOARD OF LAND SURVEYORS, JAN. 28, 19
REVISED MAY 14, 19
REVISED JAN., 19