MARQUETTE COUNTY REMONUMENTATION

CORNER RATIFICATION FORM

SURVEY & REMONUMENTATION

DEC 1 6 1996

COMMISSION

LOCATION
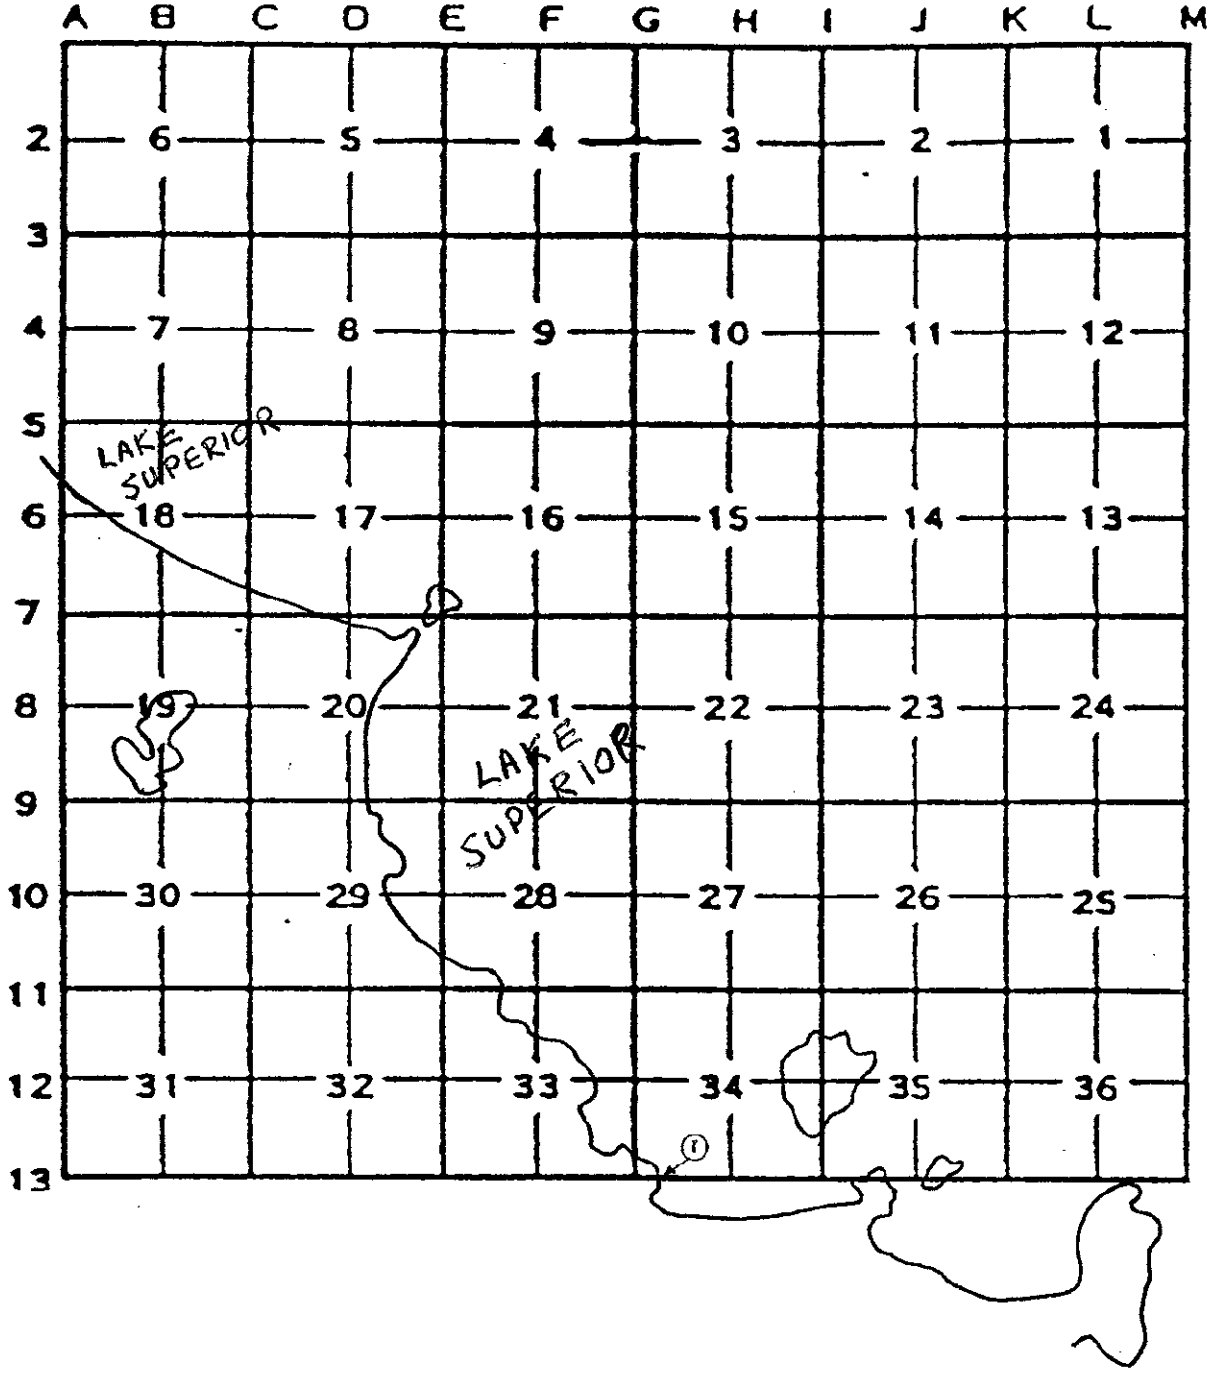
T. 49 N., R. 25 W.