LAND CORNER RECORDATION CERTIFICATE

Filing Requirement of Act 74, Mich. P.A. 1970

filed 1-24-89 RW

For corners in
MISSAUKEE
(County)

Located In:

Corner Code #

1. Public Land Survey		T 21N	R 5W	F-3
		T	R	
		T	R	
		T	R	
2. Property Controlling	S 4	T	R	14
in Section	S 4	T	R	12
3. Miscellaneous	S 4	T	R	*658.4'-W
Property in Sec.	S	T	R	OF 6-2

Register of Deeds Stamp & File Number

4. Lot No. _____ , Recorded Plat _____
5. Private Claims _____

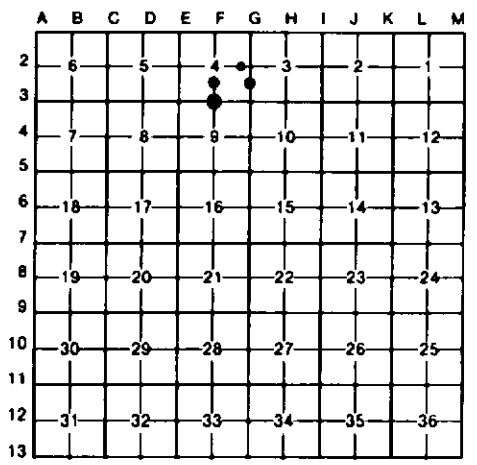

I, CARL F. ROSER, in a field survey on FEBRUARY 12, 19 87, do hereby certify that under requirements of P.A. 74, Michigan P.A. of 1970, the corner points mentioned in lines 1 and 2 above were in conformance with regulations and rules therefore as required in the current manual of survey instructions of the United States Department of the Interior, Bureau of Land Management or by a decree of a Court of Law and/or that the corner points mentioned in lines 3, 4 and 5 above were in conformance with the rules of the Michigan Board of Land Surveyors or by a Decree of a Court of Law; established, re-established, monumented, re-monumented, recovered, found as expressed below:

NOTE: Not more than 4 corners, all in the same town and range, may be recorded on this certificate.

A. Description of original monument and accessories and/or subsequent restoration:

F-3
14
12
*

B. Description of corner evidence found and/or method applied in restoring or reestablishing corner:

F-3
SET S1/4 COR S-4 MIDWAY & ON LINE BTW FD SE & SW SEC. CORS AS NOTED PER L.CAVANAGH 1976 SURVNOTES. FD HIS IRON AS SET IN ERROR S85°05'E,7.11' ADJ IT TO OUR S.P.POSITION.E-W WOVEN WIRE FN IS S 25'±.

14
ESTABLISHED SE COR OF N1/2-SE1/4 PER STANDARD BLM INSTRUCTIONS. COR FALLS IN SWP; SWP EDGE IS 525'±N.

12
ESTABLISHED SW COR OF N1/2 - SE 1/4 PER STANDARD BLM INSTRUCTIONS. B-WIRE RUNS S&E FROM A TREE THAT IS S08°W 30' FROM SET COR;WIRE CROOKED & IN TREES ONLY-SINGLE STRAND SMOOTH WIRE.

*
ESTABLISHED SW COR OF E1/2-SE1/4-NE1/4 OF S-4 PER STANDARD BLM INSTRUCTIONS. CENTER OF N-S TRAIL RD IS 135'E.

C. Description of monument for corner and accessories established to perpetuate locating the position of the corner:

F-3
SET DWR NON & CEDAR POST

5" MAPLE	N84°E	17.36'
4" MAPLE	S34°W	16.81'
7" MAPLE	S80°W	11.52'
8" OAK	N06°E	33.23'

14
DROVE 3/8" X 80" PIPE W/RLS CAP & SET CED POST

8" CEDAR	N34°W	6.6'
6" CEDAR	S46°E	15.1'
9" CEDAR	N20°E	32.8'

12
DROVE 5/8" X 34" REROD W/RLS CAP & SET CEDAR POST W/LOC TAG.

6" MAPLE	N42°E	27.4'
5" MAPLE	N56°W	21.4'
12" MAPLE CLP	S22°W	28.2'
5" MAPLE	S44°W	40.5'

*
DROVE 5/8" X 34" REROD W/RLS CAP & SET CED POST W/LOC TAG

6" SPRUCE	S76°E	21.4'
11" TW.MAPLE	N08°E	42.0'
6" W.PINE	S54°W	60.0'

Signed by Carl F. Roser 10-25-88 Date _____

Surveyor's Michigan License No. 12028

STATE OF MICHIGAN
CARL F. ROSER
LAND SURVEYOR
No. 12028
REGISTERED LAND SURVEYOR

FORM APPROVED BY MICHIGAN STATE BOARD OF LAND SURVEYORS JAN. 1971
REVISED MAY 14, 1975
REVISED JAN., 1983