LAND CORNER RECORDATION CERTIFICATE

Filing Requirement of Act 74, Mich. P.A. 1970

For corners in
MISSAUKEE
(County)

	Located In:	Corner Code ##
1. Public Land Survey	T 21N R 5W	H-11, I-11
	T ____ R ____	I-12
	T ____ R ____	
	T ____ R ____	
2. Property Controlling	S ____ T ____ R ____	
in Section	S ____ T ____ R ____	
3. Miscellaneous	S ____ T ____ R ____	
Property in Sec.	S ____ T ____ R ____	

Register of Deeds Stamp & File Number

4. Lot No. _____ , Recorded Plat _____
5. Private Claims _____

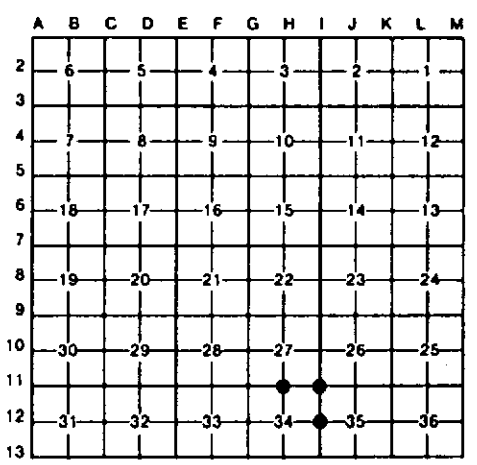

I, CARL F. ROSER, in a field survey on FEBRUARY 20, 19 90, do hereby certify that under requirements of P.A. 74, Michigan P.A. of 1970, the corner points mentioned in lines 1 and 2 above were in conformance with regulations and rules therefore as required in the current manual of survey instructions of the United States Department of the Interior, Bureau of Land Management or by a decree of a Court of Law and/or that the corner points mentioned in lines 3, 4 and 5 above were in conformance with the rules of the Michigan Board of Land Surveyors or by a Decree of a Court of Law; established, re-established, monumented, re-monumented, recovered, found as expressed below:

NOTE: Not more than 4 corners, all in the same town and range, may be recorded on this certificate.

A. Description of original monument and accessories and/or subsequent restoration:

H-11 I-11 I-12

B. Description of corner evidence found and/or method applied in restoring or reestablishing corner:

H-11
ACCEPTED 2" PIPE FOR N 1/4 COR SEC 34. PIPE BELIEVED TO BE BY M. SCHAAF. (SCHAAF FD BOTH USBT'S HERE IN 1938.) CTR OF E-W WINDING TRAIL IS 60'± 3' N.

I-11
SET DNR MON FOR NE COR SEC 34. COR SET SINGLE PROPORTION BETWEEN FD COR'S 1/2 MILE N & 1 MILE S. CYCLE TRAIL N'LY & SW'LY IS 51'±E. RESTORED THIS COR S.P. N & S AS THIS IS G.L.O. 1852 RESURVEY WHICH RAN SOUTH RANDOM 3 MILES FROM CTR OF TWP & CORR. NORTH 3 MILES. COR RESTORATION ALSO FIT RECORD SCHAAF DIST. WEST 1/2 MILE TO FD N 1/4 COR OF S-34.

I-12
SET DNR MON FOR E 1/4 COR SEC 34 PROPORTIONATE MEAS TO FD COR'S 1 MILE N & 1/2 MILE S. COR IS 39' N & 16' E OF APPROX INTERSECTION OF TRAIL ROADS S, N & NE.

C. Description of monument for corner and accessories established to perpetuate locating the position of the corner:

H-11
FD 2" PIPE; ADDED 1" X 4' GALV PIPE W/RLS CAP & SET CED POST W/LOC TAG.

22" R PINE	N35°W	48.5'
14" R OAK	N45°E	36.6'
6" MAPLE (CLP 3)	S45°E	8.4'
8" MAPLE	S15°W	7.1'

I-11
SET DNR MON & CED POST.

15" R OAK	N10°W	35.0'
6" R PINE	N85°E	58.8'
14" R OAK	S10°W	9.4'
18" R OAK	S70°W	28.2'

I-12
SET DNR MON & CED POST.

11" R PINE	N15°E	28.0'
13" R PINE	S45°E	89.7'
2" OAK	S 5°E	9.3'
18" OAK (CLP 3)	S70°W	62.1'

FD OLD 1 1/4"X5' PIPE. S09°30'W 82.08

STATE OF MICHIGAN
CARL F. ROSER
LAND SURVEYOR
No. 12028
REGISTERED LAND SURVEYOR

Signed by Carl F. Roser 5-22-92 Date _____

Surveyor's Michigan License No. 12028

FORM APPROVED BY MICHIGAN STATE BOARD OF LAND SURVEYORS, JAN. 28, 1971
REVISED MAY 14, 1975
REVISED JAN., 1983