LAND CORNER RECORDATION CERTIFICATE
Filing Requirement of Act 74, Mich. P.A. 1970

For corners in
MISSAUKEE
(County)

	Located In:	Corner Code 77
1. Public Land Survey	T 23N R 05W	H-3, G-3
	T ___ R ___	
	T ___ R ___	
	T ___ R ___	
2. Property Controlling	S 10 T 23N R 05W	5
in Section	S ___ T ___ R ___	
3. Miscellaneous	S 10 T 23N R 05W	::988.8 N OF H-4
Property in Sec.	S ___ T ___ R ___	

Register of Deeds Stamp & File Number

4. Lot No. ___, Recorded Plat ___
5. Private Claims ___

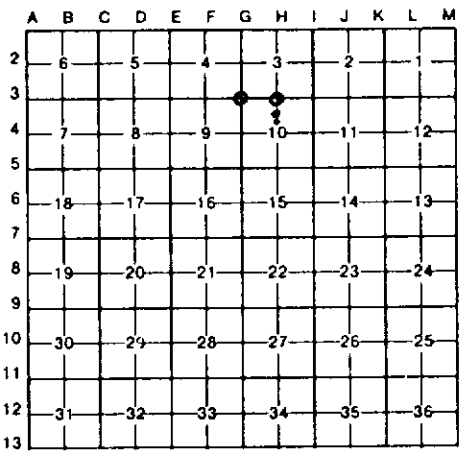

I, CARL F. ROSER, in a field survey on APRIL 16, 19 86, do hereby certify that under requirements of P.A. 74, Michigan P.A. of 1970, the corner points mentioned in lines 1 and 2 above were in conformance with regulations and rules therefore as required in the current manual of survey instructions of the United States Department of the Interior, Bureau of Land Management or by a decree of a Court of Law and/or that the corner points mentioned in lines 3, 4 and 5 above were in conformance with the rules of the Michigan Board of Land Surveyors or by a Decree of a Court of Law; established, re-established, monumented, re-monumented, recovered, found as expressed below:

NOTE: Not more than 4 corners, all in the same town and range, may be recorded on this certificate.

C. (CONTINUED)
XXXX