JUDITH D. ROEHM IF
Ontonagon County
Page 1 of 1 LC 5/ 79
JEN Rec. Date 06/22/98 Time 11:32
RECORDING FEE: 9.00

LAND CORNER RECORDATION CERTIFICATE
Filing Requirement of Act 74, Mich. P.A. 1970

For corners in ONTONAGON (County) Located in: Corner Code #

1. Public Land Survey T51N R42W K-10
   T___ R___
   T___ R___
   T___ R___
2. Property Controlling in Section S___ T___ R___
   S___ T___ R___
3. Miscellaneous Property in Sec. S___ T___ R___
   S___ T___ R___

JAN 11 1999
SECTION

Register of Deeds Stamp & File Number

4. Lot No. _____, Recorded Plat _____
5. Private Claims _____

¼ Corner common to Sections 25 & 26 T51N R42W.

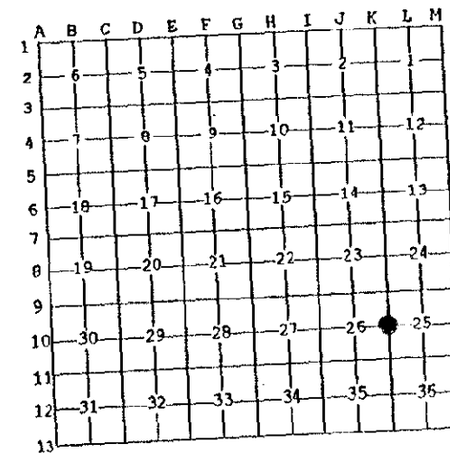

I, Earl W. Applekamp, in a field survey on June 09, 1998 do hereby state that under requirements of P.A. 74, Michigan P.A. of 1970, the corner points mentioned in lines 1 and 2 above were in conformance with regulations and rules therefore as required in the current manual of survey instructions of the United States Department of the Interior, Bureau of Land Management or by a decree of a Court of Law and /or that the corner points mentioned in lines 3, 4 and 5 above were in conformance with the rules of the Michigan Board of Land Surveyors or by a Decree of a Court of Law; established, re-established, monumented, recovered, found as expressed below:

NOTE: Not more than 2 corners, all in the same town and range, may be recorded on this certificate.

A. Description of original monument and accessories and/or subsequent restoration:

Original corner established by S.W. Higgins, U.S. Deputy Surveyor, summer of 1846. Set Wood Post.

ORIGINAL BEARING TREES:

10" Maple	N20°W	5.28 feet
12" Sugar	S35°E	3.30 feet

B. Description of corner evidence found and/or method applied in restoring or reestablishing corner:

No original or other evidence was found. Corner was re-established by single proportionate measure and on line between opposite section corners, North & South.

Research on file with the Ontonagon County Remonumentation Program Representative.

PEER GROUP APPROVED
Earl W Applekamp 6-17-98
COUNTY REMONUMENTATION

C. Description of monument for corner and accessories established to perpetuate locating the position of the corner:

At the corner position I set a 2½"X30" split base aluminum pipe with a 3" cap stamped to read: County Remonumentation, T51N R42W, ¼, S25, S26, 1998, P.S. 17610. I established 3 bearing trees and a reference object.

Nail in 8" Maple	N27°W	28.91'	-	Nail in 7½" Maple	S34°W	24.99'
Nail in 5½" Maple	N60°E	34.25'	-	6' Steel Sign Post	S50°E	0.86'

STATE OF MICHIGAN
EARL W. APPLEKAMP
PROFESSIONAL SURVEYOR
NO. 17610
LICENSED PROFESSIONAL SURVEYOR

Signed by Earl W Applekamp Date June 11, 1998
Surveyor's Michigan License No. 17610

FORM APPROVED BY MICHIGAN STATE BOARD OF PROFESSIONAL SURVEYORS, JAN. 26, 1971
REVISED MAY 14,1975
REVISED JAN., 1983
REVISED OCT., 1995