

LAND CORNER RECORDATION CERTIFICATE

Filing Requirement of Act 74, Mich. P.A. 1970

SECTION

For corners in

Presque Isle
(County)

Located in:

Corner Code #

1. Public Land Survey

T 34 N R 4 E

M.P. #7 ✓

2. Property Controlling
in Section

S

T R

3. Miscellaneous
Property in Sec.

S

T R

S

T R

S

T R

4. Lot No. _____, Recorded Plat _____
5. Private Claims _____

I, Ronald Bischer, in a field survey on Aug 20, 1999 do hereby state that under requirements of P.A. 74, Michigan P.A. of 1970, the corner points mentioned in lines 1 and 2 above were in conformance with regulations and rules therefore as required in the current manual of survey instructions of the United States Department of the Interior, Bureau of Land Management or by a decree of a Court of Law and /or that the corner points mentioned in lines 3, 4 and 5 above were in conformance with the rules of the Michigan Board of Land Surveyors or by a Decree of a Court of Law; established, re-established, monumented, recovered, found as expressed below:

NOTE: Not more than 2 corners, all in the same town and range, may be recorded on this certificate.

A. Description of original monument and accessories and/or subsequent restoration:

M.P. #7

1856 GLO Notes

N20°W 4 lks 16" W. Pine

N55°E 7 lks 10" Y. Pine

Aug. 22, 1983 Delmer Porter #15410

½" rod and cap #15410

N04°E 4.42' ¾" Bar

N29°W 64.56' 8" Maple

S65°E 82.06' 8" Birch

B. Description of corner evidence found and/or method applied in restoring or reestablishing corner:

M.P. #7

Aug. 20, 1999 Presque Isle County Remonumentation

Ronald Bischer #22428

found 1 old witness

Set four new witnesses

C. Description of monument for corner and accessories established to perpetuate locating the position of the corner:

M.P. #7

½" rod and cap #15410

S62°E 95.60' 15" Maple

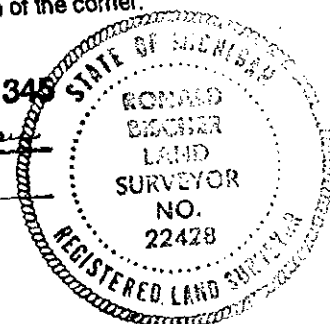
N12°W 68.64' 18" Maple

N10°E 39.39' 6" Cedar

North 1.25' ½" rod and cap #15410

N29°W 64.56' 8" Maple

Notified by Peer Group
in accordance with P.A. 345

Chairman Norman J. [Signature]Date 11/30/99Signed by Ronald E. BischerSurveyor's Michigan License No. 22428Date 12-13-99