

FEB 12 2001

LAND CORNER RECORDATION CERTIFICATE
Filing Requirement of Act 74, Mich. P.A. 1970

SECTION

For corners in

Presque Isle
(County)

Located in:

Corner Code #

1. Public Land Survey

T35NR 2E

G-2

T R

T R

T R

2. Property Controlling
in Section

S

T R

S

T R

3. Miscellaneous
Property in Sec.

S

T R

S

T R

PRESQUE ISLE COUNTY
RECORDED

2000 DEC 11 AM 9:51

James M. Jamet
REGISTER OF DEEDS

Register of Deeds Stamp & File Number

4. Lot No. _____, Recorded Plat _____

5. Private Claims _____

I, Ronald Bischer, in a field survey on 10/26/00 do hereby state that under requirements of P.A. 74, Michigan P.A. of 1970, the corner points mentioned in lines 1 and 2 above were in conformance with regulations and rules therefore as required in the current manual of survey instructions of the United States Department of the Interior, Bureau of Land Management or by a decree of a Court of Law and/or that the corner points mentioned in lines 3, 4 and 5 above were in conformance with the rules of the Michigan Board of Land Surveyors or by a Decree of a Court of Law; established, re-established, monumented, recovered, found as expressed below:

NOTE: Not more than 2 corners, all in the same town and range, may be recorded on this certificate.


A. Description of original monument and accessories and/or subsequent restoration:

August 1855 George Cannon Set wood Post and 2 witnesses

Oct. 1997 Ronald Bischer #22428 Set $\frac{1}{2}$ " rod and cap #22428 at recorded distances from OBT stumps
found 2 original witnesses left 4 new witnesses

B. Description of corner evidence found and/or method applied in restoring or reestablishing corner:

Set $\frac{1}{2}$ " rod and cap from both OBT stumps
left 4 new witnesses

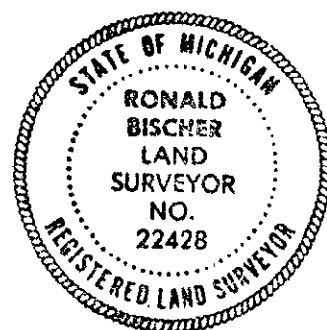

C. Description of monument for corner and accessories established to perpetuate locating the position of the corner:

Oct. 26, 2000
 $\frac{1}{2}$ " rod and cap #22428

S70° E 22.00' 14" Cedar
N21° W 12.30' 5" Cedar
S64° W 28.32' 12" Cedar
S17° E 14.95' 12" Cedar
Both OBTs in place

Ratified by Peer Group
in accordance with P.A. 345

Chairman *Norman J. Ormiston*Date 12-11-00Signed by Ronald R. BischerDate 11-7-2000Surveyor's Michigan License No. 22428