LIBER 1 PAGE 459

RECEIVED FOR RECORD
94 AUG 12 PM 2:37
LIBER NO. 1 PAGE NO. 459
ESTHER LEE
REGISTER OF DEEDS
SANILAC CO., MICHIGAN

REMONUMENTATION

LAND CORNER RECORDATION CERTIFICATE

Filing Requirement of Act 74, Mich. P.A. 1970

For corners in

Sanilac (County)

	Located In:	Corner Code #
1. Public Land Survey	T 10N R 16E	M - 8, M - 9
	T ___ R ___	
	T ___ R ___	
	T ___ R ___	
2. Property Controlling	S ___ T ___ R ___	
in Section	S ___ T ___ R ___	
3. Miscellaneous	S ___ T ___ R ___	
Property in Sec.	S ___ T ___ R ___	

Register of Deeds Stamp & File Number

4. Lot No. _____, Recorded Plat _____
5. Private Claims _____

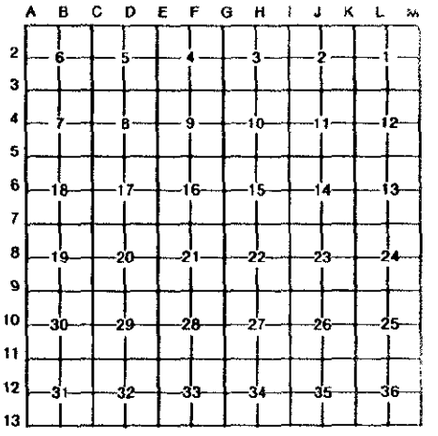

I, John A Milletics, in a field survey on July 16, 19 94, do hereby certify that under requirements of P.A. 74, Michigan P.A. of 1970, the corner points mentioned in lines 1 and 2 above were in conformance with regulations and rules therefore as required in the current manual of survey instructions of the United States Department of the Interior, Bureau of Land Management or by a decree of a Court of Law and/or that the corner points mentioned in lines 3, 4 and 5 above were in conformance with the rules of the Michigan Board of Land Surveyors or by a Decree of a Court of Law; established, re-established, monumented, re-monumented, recovered, found as expressed below:

NOTE: Not more than 4 corners, all in the same town and range, may be recorded on this certificate.

A. Description of original monument and accessories and/or subsequent restoration:

M - 8 Found P.K. Nail in new Blacktop over former location of Monu Box as recorded in Liber 4 on Page 74 of the Sanilac Co. Records

M - 9 Found Monu Box in centerline of U.S. 25 and Harrington Road as per Plat recorded Liber 3, Page 91

Approved Peer Board Meeting
Aug. 9, 1994 [signature]
JM

B. Description of corner evidence found and/or method applied in restoring or reestablishing corner:

M - 8
E 1/4 Cor Section 24 T10N-R16E
Found P.K. Nail

M - 9
SE Cor Section 24 T10N-R16E
Found Monu Box

SURVEY & REMONUMENTATION
SEP 07 1994
COMMISSION

C. Description of monument for corner and accessories established to perpetuate locating the position of the corner:

M - 8
E 1/4 Cor Section 24 T10N-R16E
Monu Box
S85°W 49.50 to a nail N side of a Tele Pole
S35°E 84.00 to a nail SW side of a Power Pole
N35°E 91.60 to a Sign Pole
West 1.2 to the existing centerline of U.S. 25

M - 9
SE Cor Section 24 T10N-R16E
Monu Box
S45°W 56.4 to the NE Cor of Michigan Bell Box
West 1.50 to the centerline of U.S. 25
N45°W 67.85 to a nail N side of a Tele Pole
N45°E 51.00 to a nail N side of a Power Pole

Signed by John A Milletics Date July 24 94

Surveyor's Michigan License No. 25859

FORM APPROVED BY MICHIGAN STATE BOARD OF LAND SURVEYORS, JAN. 28, 1971
REVISED MAY 14, 1975
REVISED JAN., 1983