SURVEY & REMONUMENTATION

JAN 21 1999

SECTION

SCHOOLCRAFT COUNTY
PEER GROUP APPROVED
DATE 10/21/98 JOB

LAND CORNER RECORDATION CERTIFICATE
Filing Requirement of Act 74, Mich. P.A. 1970

For corners in

Schoolcraft (County)

	Located In:	Corner Code #
1. Public Land Survey	T41NR16W	A-3
	T41NR17W	M-3
	T___R___	
	T___R___	
2. Property Controlling in Section	S___ T___R___	
	S___ T___R___	
3. Miscellaneous Property in Sec.	S___ T___R___	
	S___ T___R___	

SIGRID HEDBERG 1P
SCHOOLCRAFT CO.REGISTER
Page 1 of 1 LC 4/ 208
JLO Rec. Date 12/03/98 Time 14:25
REVENUE FEES: 9.00

Register of Deeds Stamp & File Number

4. Lot No. _____, Recorded Plat _____
5. Private Claims _____

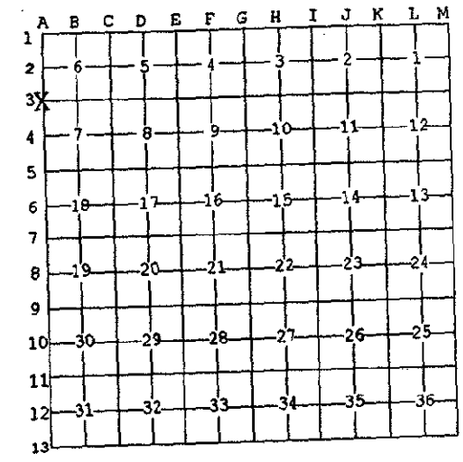

I, Thomas P.O'Brien in a field survey on Oct.22, 19 98 do hereby state that under requirements of P.A. 74, Michigan P.A. of 1970, the corner points mentioned in lines 1 and 2 above were in conformance with regulations and rules therefore as required in the current manual of survey instructions of the United States Department of the Interior, Bureau of Land Management or by a decree of a Court of Law and /or that the corner points mentioned in lines 3, 4 and 5 above were in conformance with the rules of the Michigan Board of Land Surveyors or by a Decree of a Court of Law; established, re-established, monumented, recovered, found as expressed below:

NOTE: Not more than 2 corners, all in the same town and range, may be recorded on this certificate.

A. Description of original monument and accessories and/or subsequent restoration:

A3 NW Corner Section 7, T41N - R16W
July 29, 1845 - John Burt D.S. set post corner of sections 6 and 7, T41N - R16W and sections 1 and 12, T41N - R17W, referenced by:
Y. Birch 8 S 50 W 17 Y. Birch 8 N 73 W 21

B. Description of corner evidence found and/or method applied in restoring or reestablishing corner:

A3 Oct. 22, 1998 - Thomas P. O'Brien P.S. recovered a 3/4" iron pipe with top bent 3.0' below gravel surface on East shoulder of Co. Road 455. Reset 3/4" iron pipe with Schoolcraft County Monument stamped to identify.

C. Description of monument for corner and accessories established to perpetuate locating the position of the corner:

A3 Schoolcraft County Monument stamped to identify. Established the following references which are blazed, scribed, painted and tagged :

NBT 12" Maple - N58°E - 50.79'
NBT 10" Maple - S38°E - 65.48'
NBT 10" Maple - S74°W - 105.78'
NBT 8" Maple - N35°W - 120.82'
Centerline County Rd. 455 - West - 15.50'
Carsonite post - East - 20.0'

STATE OF MICHIGAN
THOMAS P. O'BRIEN
PROFESSIONAL SURVEYOR
NO. 21274
LICENSED PROFESSIONAL SURVEYOR

Signed by Thomas P. O'Brien Date November 29, 1998

Surveyor's Michigan License No. 21274

FORM APPROVED BY MICHIGAN STATE BOARD OF PROFESSIONAL SURVEYORS, JAN. 26, 1971
REVISED MAY 14,1975
REVISED JAN., 1983
REVISED OCT., 1995