JAN 3 0 1996

COMMISSION

SCHOOLCRAFT COUNTY PEER GROUP APPROVED

DATE May 12, 1995

LAND CORNER RECORDATION CERTIFICATE

Filing Requirement of Act 74, Mich. P.A. 1970

For corners in

Schoolcraft (County)

	Located In:	Corner Code ##
1. Public Land Survey	T 42 N R 15 W	D-13
	T 41 N R 15 W	D-1
	T ___ R ___	
	T ___ R ___	
2. Property Controlling	S ___ T ___ R ___	
in Section	S ___ T ___ R ___	
3. Miscellaneous	S ___ T ___ R ___	
Property in Sec.	S ___ T ___ R ___	

Received & Filed this 6 day of Dec. 1995 at 11:40 A M

Sigrid I. Hedberg
Schoolcraft Co. Reg. of Deeds

Register of Deeds Stamp & File Number

4. Lot No. _____, Recorded Plat _____
5. Private Claims _____

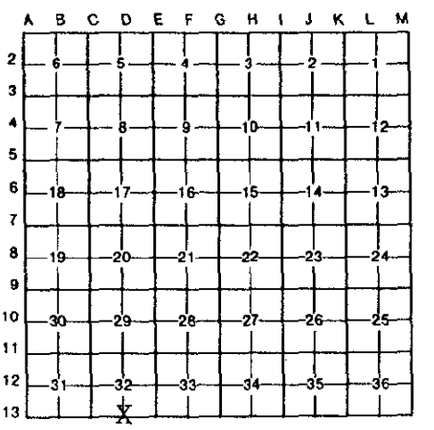

I, Thomas P. O'Brien, in a field survey on Oct. 6, 19 95, do hereby certify that under requirements of P.A. 74, Michigan P.A. of 1970, the corner points mentioned in lines 1 and 2 above were in conformance with regulations and rules therefore as required in the current manual of survey instructions of the United States Department of the Interior, Bureau of Land Management or by a decree of a Court of Law and/or that the corner points mentioned in lines 3, 4 and 5 above were in conformance with the rules of the Michigan Board of Land Surveyors or by a Decree of a Court of Law; established, re-established, monumented, re-monumented, recovered, found as expressed below:

NOTE: Not more than 4 corners, all in the same town and range, may be recorded on this certificate.

A. Description of original monument and accessories and/or subsequent restoration:

D-13 (South 1/4 Corner Sec. 32)
Aug. 6, 1845 John Burt D.S. set qr. section post.
Hemlock 18 N6W 16 W. Pine 22 N71E 13

B. Description of corner evidence found and/or method applied in restoring or reestablishing corner:

D-13 Dec.20,1994 Thomas P. O'Brien, PS recovered a 3/8" iron bar w/RLS #21274 cap set over the center of a 1½" iron pipe 16" below road surface. The corner position as recovered has been used in previous surveys of record.

C. Description of monument for corner and accessories established to perpetuate locating the position of the corner:

D-13 3|8" iron bar w|RLS 21274 cap set in monument box.
Witnesses:
Power Pole N47°E 34.25'
12"Maple S44°E 83.9'
6"Maple S26°W 96.62'
8"Maple N87°W 76.7'

STATE OF MICHIGAN THOMAS P. O'BRIEN PROFESSIONAL SURVEYOR NO. 21274 LICENSED PROFESSIONAL SURVEYOR

Signed by Thomas P.O'Brien, PS Date Dec.4, 1995

Surveyor's Michigan License No. 21274

FORM APPROVED BY MICHIGAN STATE BOARD OF LAND SURVEYORS, JAN. 28, 1971
REVISED MAY 14, 1975

LIBER PAGE