LAND CORNER RECORDATION CERTIFICATE
Filing Requirement of Act 74, Mich. P.A. 1970 as Amended

For corners in

Schoolcraft (County)

		Located In:		Corner Code #
1. Public Land Survey		T 46N	R 15W	K4
		T____	R____	
		T____	R____	
	S____	T____	R____	
2. Property Controlling	S 3	T 46N	R 15W	7
in Section	S____	T____	R____	
3. Miscellaneous	S____	T____	R____	
Property in Sec.	S____	T____	R____	

Register of Deeds Stamp & File Number

4. Lot No. _____ , Recorded Plat_____

5. Private Claims

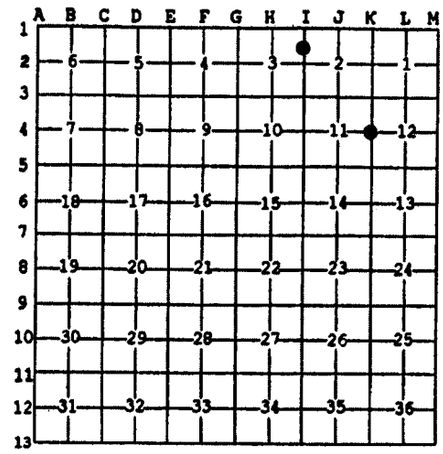

Jun 21 2006

I, Stephan J. Szyszkoski, in a field survey on _____, 20____ do hereby state that under requirements of P.A. 74, Michigan P.A. of 1970, the corner points mentioned in lines 1 and 2 above were in conformance with regulations and rules therefore as required in the current manual of survey instructions of the United States Department of the Interior, Bureau of Land Management or by a decree of a Court of Law and /or that the corner points mentioned in lines 3, 4 and 5 above were in conformance with the rules of the Michigan Board of Land Surveyors or by a Decree of a Court of Law; established, re-established, monumented, recovered, found as expressed below:

NOTE: Not more than 2 corners, all in the same town and range, may be recorded on this certificate.

A. Description of original monument and accessories and/or subsequent restoration:

(K4) Quarter corner common to Sections 11 and 12. 1850 - Established by Guy Carleton, Deputy Surveyor, midway and on the Section line between Section corners 40.47 chains north and south. Set post. Cedar 9 S25E 6 links, Cedar 12 N37W 9 links. Found no subsequent record.
(7-Sec. 3) North 1/16 corner between Sections 2 and 3. Not established in the original survey. Found no subsequent record.

B. Description of corner evidence found and/or method applied in restoring or reestablishing corner:

(K4) The original post and accessories were not recovered. Found no evidence of the position of the original corner on the ground. Reestablished the corner midway and on the Section line between Section corners 2677.55' north and south.
(7-Sec. 3) Established the corner on the Section line between Section corner 1331.02' north and Quarter corner 1345.00' south, being 20 chains, proportionate to the original record, south of the Section corner, in accordance with the original government plat for this township. From the corner thus established I found a 1.5" PVC pipe driven into the ground N22E 12.25' distant.

C. Description of monument for corner and accessories established to perpetuate locating the position of the corner:

(K4) Set 1"IDx36" I.pipe with 4" alum. MDNR cap. Set measuring nails in:
8" Cherry N01E 32.43' mrkd "1/4S N8T"
6" Cherry N11E 24.97' do
6" twin Cherry S82E 81.12' do
9" Cherry S71W 76.4' do
Bearings are magnetic. Distances are to nail with tag.

(7) Set 1"IDx36" I.pipe with 4" alum. MDNR cap. Set measuring nails in:
9" Maple S86W 8.15' mrkd "N1/16 8T"
24" Hemlock S18W 15.85' do
12" Maple S63E 27.95' do
10" Maple N25E 28.0' do
Bearings are magnetic. Distances are to nail with tag.

STATE OF MICHIGAN
STEPHAN J. SZYSZKOSKI
LAND SURVEYOR
No. 33986
LICENSED LAND SURVEYOR

Signed by Stephan J. Szyszkoski Date 8/15/06

Surveyor's Michigan License No. 33986

For the Michigan Department of Natural Resources, Office of Land and Facilities

FORM APPROVED BY MICHIGAN STATE BOARD OF PROFESSIONAL SURVEYORS, JAN. 28, 1971
Revised May 14, 1975
Revised Jan., 1983
Rervised Oct., 1995