LAND CORNER RECORDATION CERTIFICATE

Filing Requirement of Act 74, Mich. P.A. 1970

For corners in
MEXFORD
(County)

	Located In:	Corner Code ##
1. Public Land Survey	T 21N R 10W	1-13, J-13,
	T ____ R ____	K-13, L-13
	T ____ R ____	
	T ____ R ____	
2. Property Controlling	S ____ T ____ R ____	
in Section	S ____ T ____ R ____	
3. Miscellaneous	S ____ T ____ R ____	
Property in Sec.	S ____ T ____ R ____	

Register of Deeds Stamp & File Number

4. Lot No. _____ , Recorded Plat _____
5. Private Claims _____

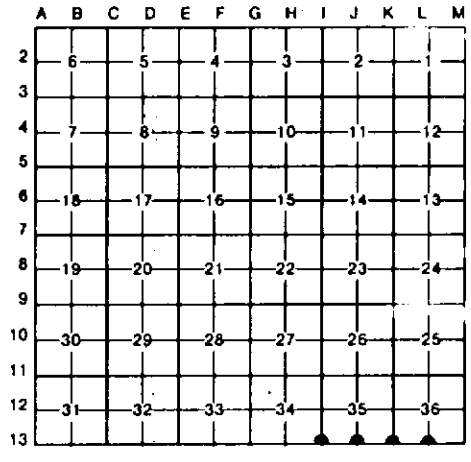

I, CARL F. ROSER , in a field survey on 2-28 , 19 91 , do hereby certify that under requirements of P.A. 74, Michigan P.A. of 1970, the corner points mentioned in lines 1 and 2 above were in conformance with regulations and rules therefore as required in the current manual of survey instructions of the United States Department of the Interior, Bureau of Land Management or by a decree of a Court of Law and/or that the corner points mentioned in lines 3, 4 and 5 above were in conformance with the rules of the Michigan Board of Land Surveyors or by a Decree of a Court of Law; established, re-established, monumented, re-monumented, recovered, found as expressed below:

NOTE: Not more than 4 corners, all in the same town and range, may be recorded on this certificate.

A. Description of original monument and accessories and/or subsequent restoration:

I-13
J-13
K-13
L-13

STATE OF MICHIGAN
CARL F. ROSER
LAND SURVEYOR
No. 12028
REGISTERED LAND SURVEYOR

B. Description of corner evidence found and/or method applied in restoring or reestablishing corner:

I-13
FD 1" PIPE FOR GW COR S-35. COR FITS 3, RLS, J. ERICKSON WIT.

J-13
FD 5/8" IRON ROD FOR S1/4 COR OF SEC 35 PER CERT OF SURVEY BY RLS JACK ERICKSON; L.01-P6. 181, 1974. CTR OF E-W BIT SURFACE RD (BY SPLIT OF 20'WD EDGE OF METAL) IS 0.5'-SOUTH.

K-13
PREVIOUS DEPT (CONSERVATION) MONUMENT OF RECORD; RLS. KEN OSTLING, 11-14-61. "FD. LARGE SQ'D POST AT CORNER AS ESTABLISHED BY CO. SURVEYOR, SOUR'S, DATE UNKNOWN, PROBABLY EARLY 1900'S."

L-13
FD 1" PIPE FOR S1/4 S-36 AS SET SINGLE PROPORTION BY MSHD IN 1963 SURVEY.

C. Description of monument for corner and accessories established to perpetuate locating the position of the corner:

I-13
FD 1" PIPE.
*POWER POLE N60°W 56.51'
*8" SCOTCH PINE S05°W 37.89'
*5" SCOTCH PINE S55°W 54.52'
POWER POLE N60°E 72.06'
N1/4 SEC 3
T20N R10W N88°49'E 499.56'
* = RLS JACK ERICKSON WIT.

J-13
FD 5/8" IRON ROD.
NE 3,T20N R10W, N89°05'E 439.47
8" CEDAR S30°E 43.30'
9" HEMLOCK IN
CLUMP 4 S25°W 51.32'
*POWER POLE N25°W 37.58'
*24" W PINE N25°E 86.39'
CTR DRWY. N DUE W 5'
* = RLS JACK ERICKSON WITS

K-13
CONSERVATION DEPT MON & CED POST.
8" CEDAR N53°W 26.7'
12" CEDAR N03°W 37.1'
10"-4' TALL SQED
CED STP N35°E 2.8'
10" CEDAR N67°E 22.6'
9" CEDAR S45°W 3.7'
E-W FN DUE S 19'

L-13
FD 1" GALV PIPE; ADDED DNR CAP & SET CED POST.
*23" R PINE N30°E 68.07'
*16 TW.R.PINE N20°W 41.39'
15" R.PINE N65°E 16.80'
NE COR SEC 2
T20N R10W N89°40'E 341.40'
*= MSHD WIT.

Signed by Carl F. Roser 03-16-91 Date _____

Surveyor's Michigan License No. 12028

FORM APPROVED BY MICHIGAN STATE BOARD OF LAND SURVEYORS, JAN. 28, 1971
REVISED MAY 14, 1975
REVISED JAN., 1983