


Township N. 21 North, Range N. 16 West Mer. (Mich.)

11-37

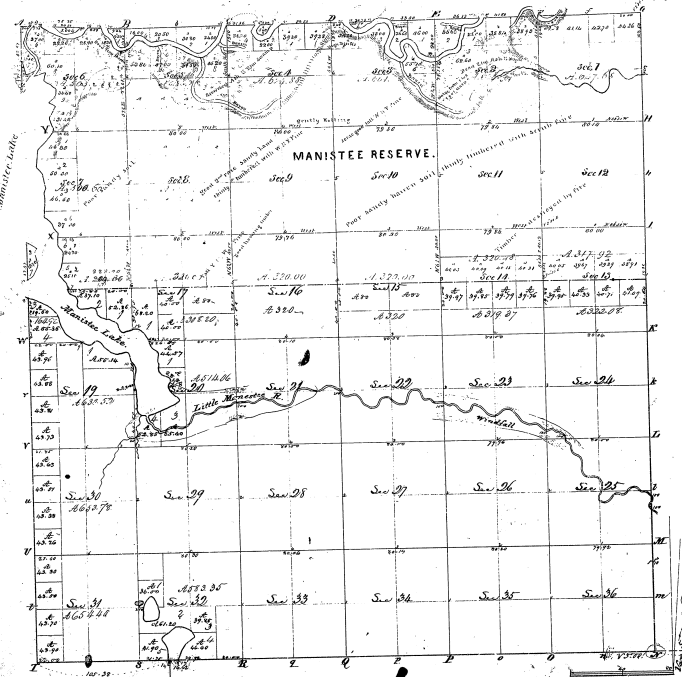

Manistee Lake





Lucius Lepp

Manistee, Mich. 11-37

17-37



The above map of Township N. 21 North of Range N. 16 West of the Principal Meridian Michigan is hereby confirmed to the field notes of the Surveyor General.