Township No. 22 N., Range No. 14 West Mer. (Mich.)

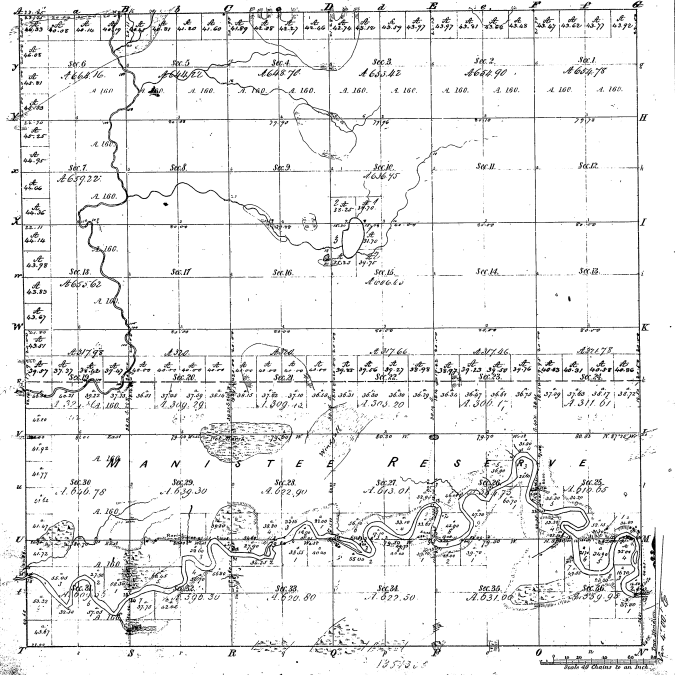

Total number of Acres 13913.57

Surveys Designated	By Whom Surveyed	Date of Contract	Amount of Surveys	When Surveyed	When if not and all in the Surr. Gen.l office
Township lines	Sam.l Ward	Nov.r 4th 1836	24 M. 37 ch. 12 l.	6th 1837	31st 1838
Subdivisions	Samuel Ward	Oct. 18. 1837	37. 12. 50	2nd 1839	3rd 1839
Total Chains	O. Weston	[illegible]	117. 21. 62	2 do 1841	

The above Map of Township No. 22 North of Range No. 14 West of the Principal Meridian Michigan is protracted conformable to the field notes of the surveys thereof returned to this office, and is hereby approved.

Surveyor Generals Office Cincinnati Aug. 15th 1839

Surr. Gen.l

Meanders of a Lake in Sections 10 & 15

Point	Course	Dist.	Point	Course	Dist.
3	N 54 W	6.00			
	N 85 W	5.00			
4	S 88 W	5.00			
	S 72 W	5.00			
	S 44 W	5.00			
	S 5 W	12.50			
	S 15 E	5.00			
	S 49 E	5.00			
	S 28 E	5.00			
	S 20 E	15.00			
5	S 7 W	5.00			

This Map of part of the Manistee Reserve in Town.[illegible] N. of Range 14 West of the Principal Meridian Michigan is plotted conformable to the field notes of the survey thereof on file in this office, which have been examined and approved.

Surveyor Generals office Detroit, Mich. 11th [illegible] 1839

Surveyor Gen.l

Illinois [illegible]

17-32

Island in Manistee River

Township No. 22 N. Range No. 14 W. **Mer. Mich.**

17-32

17-32

Meanders of									
Posts	Courses	Ch.s Lks	Posts	Courses	Ch.s Lks	Posts	Courses	Ch.s Lks

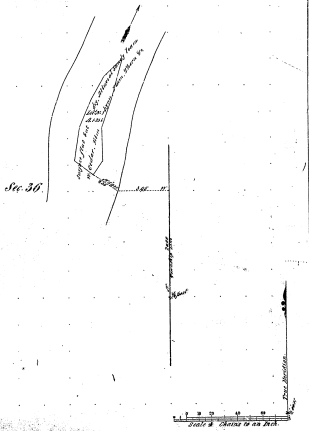

Total number of Acres

Surveys Designated.	By Whom Surveyed.	Date of Contract.	Amount of Surveys. M. Ch.s Lks	When Surveyed.	When Charged in the Surv.r Gen.l's acct.
Township lines.					
Subdivisions.	Thos. Whelpley	Instructions May 24th 1854		1856	

The above Map of Township No. 22 North of Range No. 14 West of the Principal Meridian, of Michigan is strictly conformable to the field notes of the survey thereof on file in this Office, which have been examined and approved.

Surveyor General's Office, Detroit Sept. 15th 1857.

C. L. Ernisson Sur.r Genl.