Resurvey

Township No. 48 N. Range No. 19 W. — Mer. Mich.

37-2

Grand Island

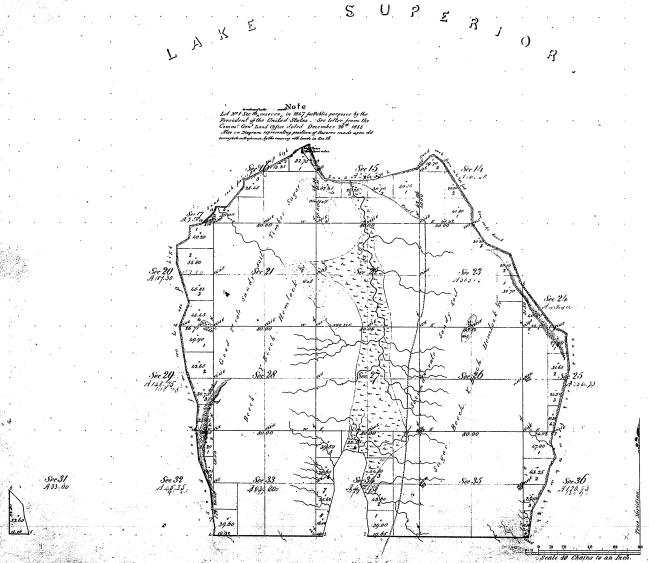

Meanders of								
Poles	Courses	Ch's Lk's	Poles	Courses	Ch's Lk's	Poles	Courses	Ch's Lk's

Meanders 12th 59th 69th

37-2

Total number of Acres 7115.06

Surveys Designated.	By Whom Surveyed.	Date of Contract.	Journal of Surveys M. Ch's Lk's	When Surveyed.	Which Changed to the Sur. Field's [illegible]
Township lines	Wm. H. Hurt	[illegible] 16th 1848	2 - [illegible]	8th June 1848	
Subdivisional Sections	Wm. H. Hurt	April 1st 1848	[illegible]	30th June 1848	

The above Map of Township No. 48 North of Range No. 19 West of the Principal Meridian Michigan is strictly conformable to the field notes of the survey thereof on file in this Office which have been examined and approved.

Surveyor General's Office
Detroit [illegible] 1848

Alexander Ticknor Jun. Surv. Genl

Regd. [illegible]
Exam. [illegible]