Township N.o 49 N. Range N.o 15 W. Mer. Mich.

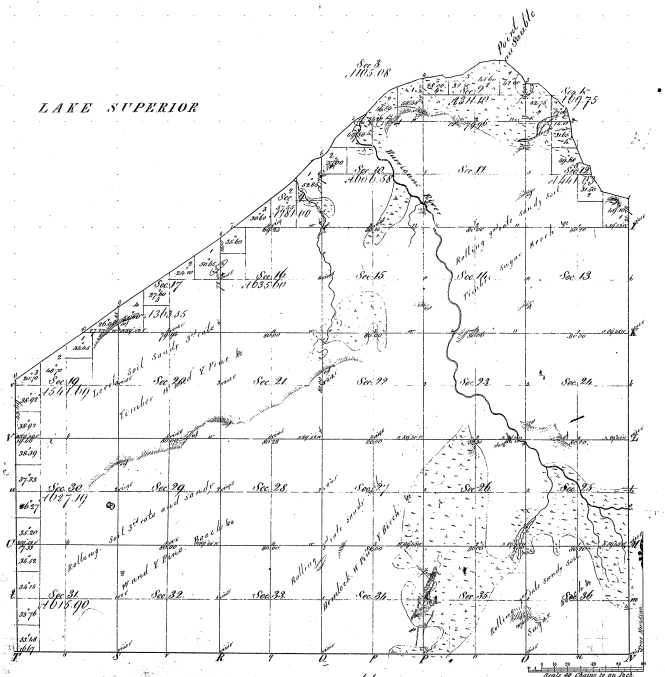

Boundaries of	Part. Courses	Dist.	Part. Courses	Dist.	Part. Courses	Dist.
36-6						

Meanders

36-6

Surveys Designated.	By Whom Surveyed.	Date of Contract.	Amount of Surveys		When Surveyed.	When Changed in the Dist' limits and
			M.	Chs	Lks	
Township lines:	William A Mack	April 1 1851	18	19	41	3rd June 1851
Subdivisions	Geo. R. Major	April August	53	18	43	3rd June 1852

Total number of Acres 16885.25

The above Map of Township N.o 49 North of Range N.o 15 West Principal Meridian, Michigan is strictly conformable to the field notes of the survey, thereof, on file in this Office, which have been examined and approved.

Surveyor Generals Office, Detroit Dec 24 1852

Chas. Ashley Asst Genl

Referred