Resurvey

Township No. 29 N. Range No. 9 W. Mer. Mich.

16-5


Surveyor General's Office
Detroit
January 5th 1852

Geo. W. Whipple
Acting Commissioner
Surveyor General of Michigan

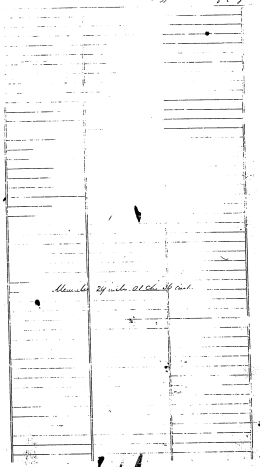

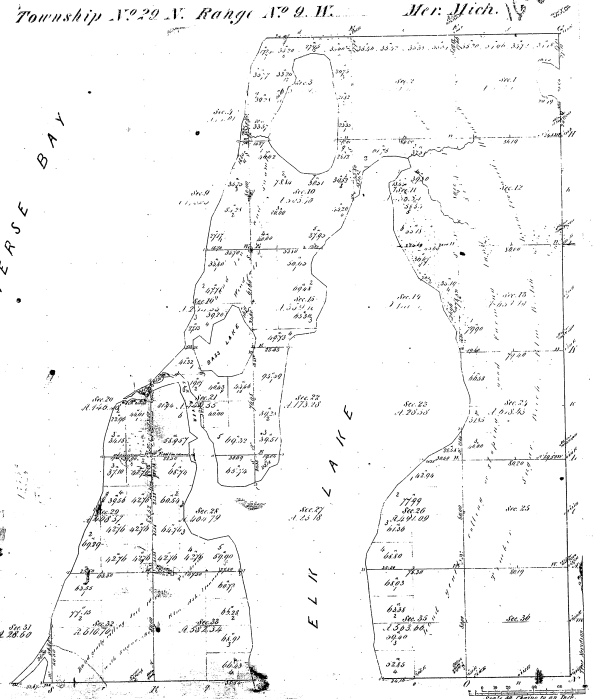


Range Designated	No. Rang. Surveyed	Date of Contract	Amount of Surveys At 1.25 Per Ac.	Whn Cleared to the Surveyor Gen'l	Whn Returned
Township lines	Chains 1620	Dated Sept 1850	111.74 85	A. Viele 1852	
Subdivisions	1854 Miles Do	Instructions	174 88		

The above Map of Township No. 29 North of Range No. 9 West of the Principal Meridian of Michigan is hereby conformable to the field notes of the survey thereof on file in the Office, which have been examined and approved.

General Land Office, Surveyor General's Office
Detroit, Jan. 5th 1852

Geo. W. Whipple Acting Surveyor General

Geo. W. Whipple Acting Surveyor General