Resurvey

Township No. 31 N. Range No. 6 W. Mer: Mich.

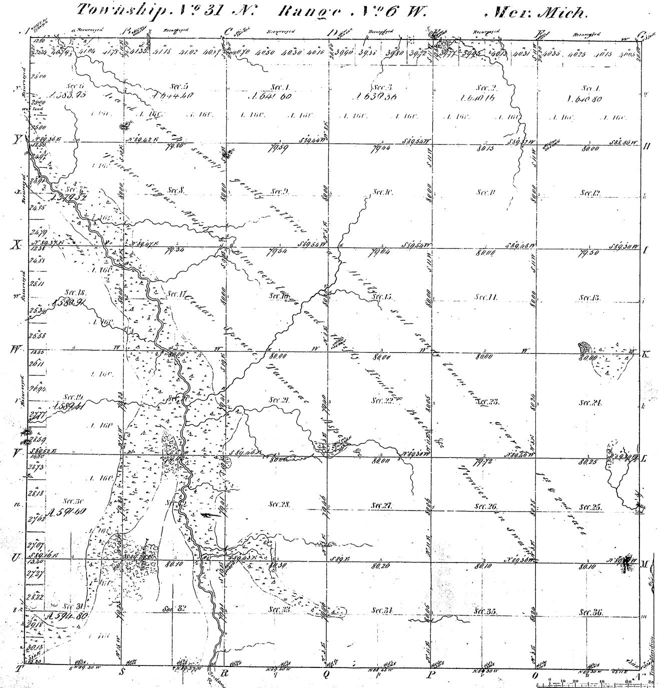

Meanders of								
Posts	Courses	Ch's Lk's	Posts	Courses	Ch's Lk's	Posts	Courses	Ch's Lk's

Total number of Acres 22,726.51

Surveys Designated	By Whom Surveyed	Date of Contract	Amount of Surveys M. Chs. Lks.	When Surveyed	When pd. for and chd. in the Sur. Genl's acct.
Township lines E.R.	John Hodgson	Jany. 26th 1836	6 00 00	2nd Quar 1839	
Subdivisions	Fredk. D. Atwater	April 10th 1856	59 39 48	2nd & 3d Quar. 1856	
South Boundary Resurveyed by	E. D. Atwater		5. 75. 30	2nd Quar 1856	

The above Map of Township No. 31 C North of Range No. 6 West of the Principal Meridian of Michigan is strictly conformable to the field notes of the survey thereof on file in this Office, which have been examined and approved.

Surveyor Generals Office
Detroit Dec. 8th 1856.

Lucius Lyon Chapman
Sur. Genl.

Com. Copy made.

1833