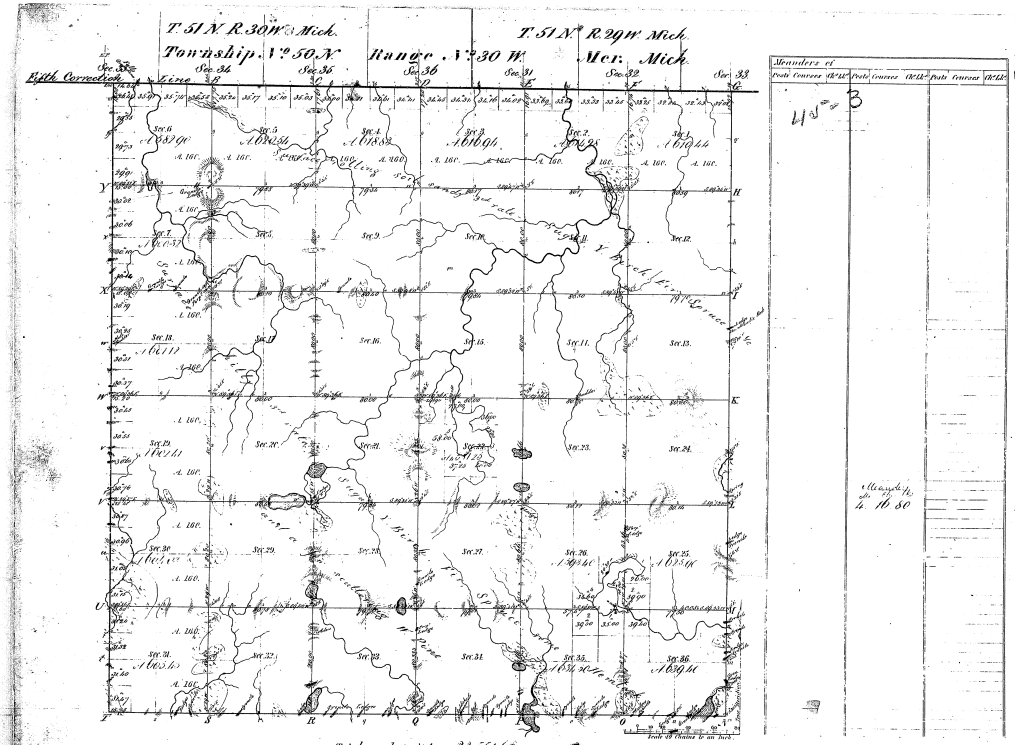

Total number of Acres. 22 551.60

Surveys Designated	By Whom Surveyed	Date of Contract	Amount of Surveys	When Surveyed	When Sec. and Sub. in the Surv. Gen.l acc.t
Township lines	W. & Jn.o S. Austin Bust	Sept. 7 1846	M. Ch. Lk. 11. 71. 67	3d Quar. 1846	
Subdivisions	Cary H. Carleton	Nov. 17 1852	63. 33. 61	2nd & 3rd Quar. 1852	

The above Map of Township No. 50 North of Range No. 30 West of the Principal Meridian Michigan is strictly conformable to the field notes of the survey thereof on file in this Office which have been examined and approved.

Surveyor General's Office
Detroit Dec. 22 1852

Charles Noble
Spr. Gen.l