Township No. 26 N. Range No. 11 West Mer. (Mich.)

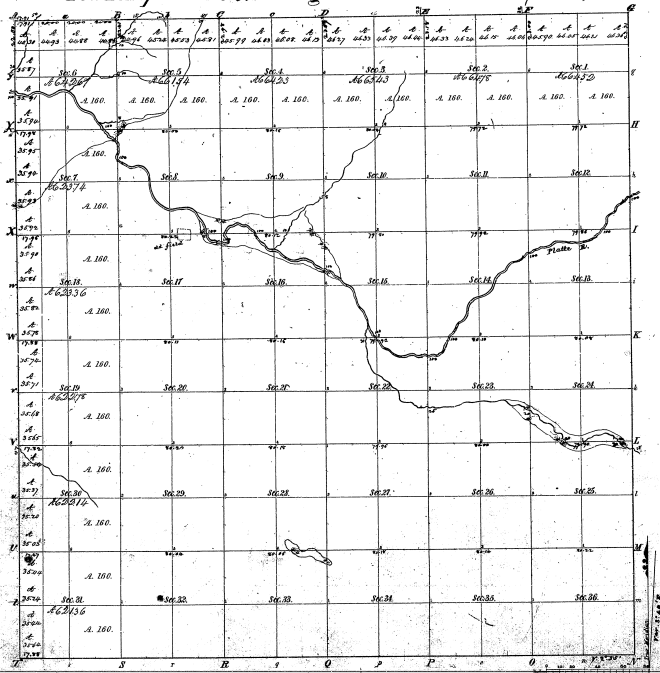

Meanders of							
Posts	Courses	Or 12th Posts	Posts	Courses	Or 12th Posts	Courses	Or 12th

17-15

Total number of Acres 23 076.55

Surveys Designated	By Whom Surveyed	Date of Contract	Amount of Surveys	When Surveyed
Township Lines	Alex. Pratt			
Subdivisions	Alex. Pratt			

The above Maps of Township No. 26 N. of Range No. 11 W. west of the Principal Meridian, Michigan, is strictly conformable to the field notes of the survey thereof on file in this Office, which have been examined and approved.

Surveyor General's Office
Detroit Dec. 25. 1839

C. P. Clairy Surveyor General