Re-Survey

Township No. 27 N. Range No. 15 W. Mer. Mich.

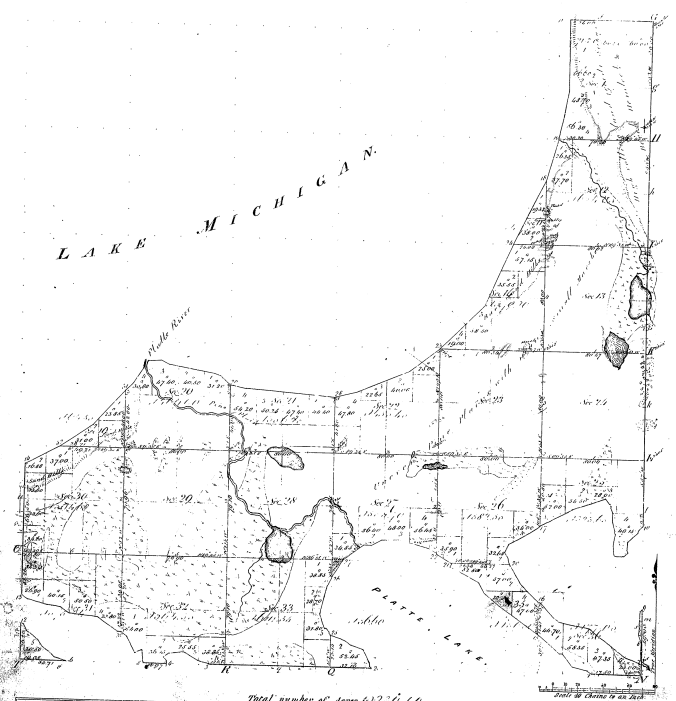

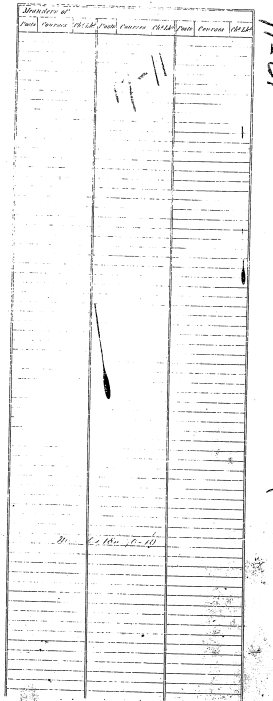

Total number of Acres 4,234.40

Surveys Designated.	By Whom Surveyed.	Date of Contract.	Amount of Surveys M.	Ch.	Lks.	When Surveyed.	When Charged in the Surr. Genl's Offs.
27 Township lines.	Moses Bush.	June 25 1838	5	79	98	2nd Quar. 1839	
[illegible]	[illegible]	April 19 1850	6	67	50	3rd Quar. 1850	
Subdivisions.	[illegible]	April 19 1850	43	52	49	3rd Quar. 1850	

The above Map of Township No. 27 North of Range No. 15 West of the Principal Meridian Michigan is a plat of the Surveys made in the field notes of the survey thereof on file in this Office, which have been examined and approved.

Surveyor General's Office.
Detroit July 31. 1851

Charles Noble Surv. Genl.

11-61

16