Re Survey

Township N.º 23 N. Range N.º 8 E. (Mich.) Mer.

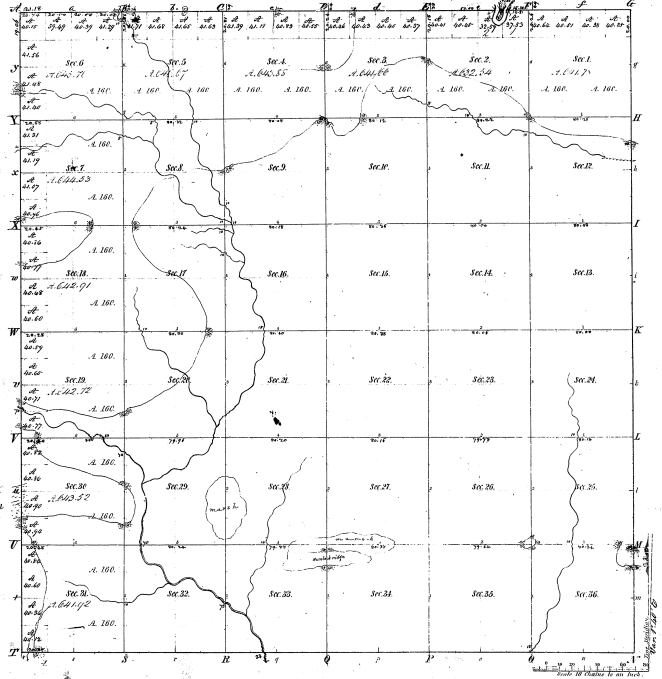

Meanders of					
Poste	Courses	100 Lk	Poste	Courses	100 Lk

Total number of Acres 23,067.89

Surveys Designated	By Whom Surveyed	Date of Contract	Amount of Surveys	When Surveyed	When the above Plat of the Survey was received in the Surveyor Gen.l's Office
Township lines	Henry Johnson	Aug.st 14th 1823	46 - 00 - 00	2.d qr. 1827	4th qr. 1829
Subdivisions	Mullett & Ward	May 27th 1823	60 43 . 74	3.d qr. 1828	4th qr. 1829

The above Map of Township 23 North of Range 8 East of the Principal Meridian Michigan is strictly conformable to the field notes of the survey thereof on file in this Office, which have been examined and approved.

Surveyor Generals Office, Cincinnati, December 9th 1829

William Johnston
Surv. Genl

Mullett & Ward 23-8 E. Mich

22-24