Resurvey

Township No. 27 N Range No. 5 W Mer. Mich.

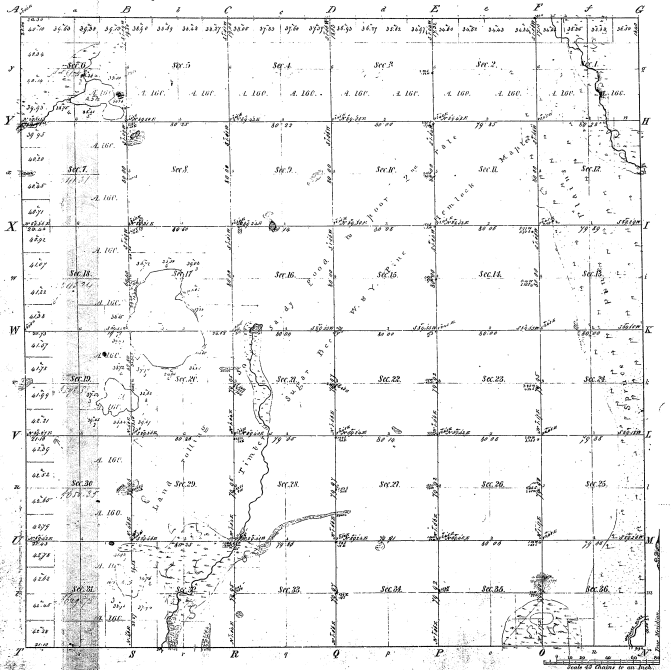

Meanders of							
Poste Courses	Chs. Lks.	Poste Courses	Chs. Lks.	Poste Courses	Chs. Lks.	Poste Courses	Chs. Lks.

15-13

Total number of Acres 22553.47

Surveys by Consultant	By Whom Surveyed	Date of Contract	Amount of Surveys	When Surveyed	When pd. for and ch.d in the Surv. Gen.l's acct.
Township line	Jas. H. Mullett	Feb.y 14th 1839	71. 79. 38	2nd Quar. 1839	
Subdivision	Geo. H. Cannon	April 20th 1852	65. 68. 74	2nd Quarter 1852	

The above Map of Township No. 27 N of Range No. 5 W of the Principal Meridian Michigan is hereby confirmed to the field notes of the survey thereof on file in this Office, which have been examined and approved.

Surveyor General's Office
Detroit Sept. 9th 1853

Leander Chapman
Sur. Genl.