15-15

Re-survey

Township No. 27 N. Range No. 7 W. Mer. Mich.

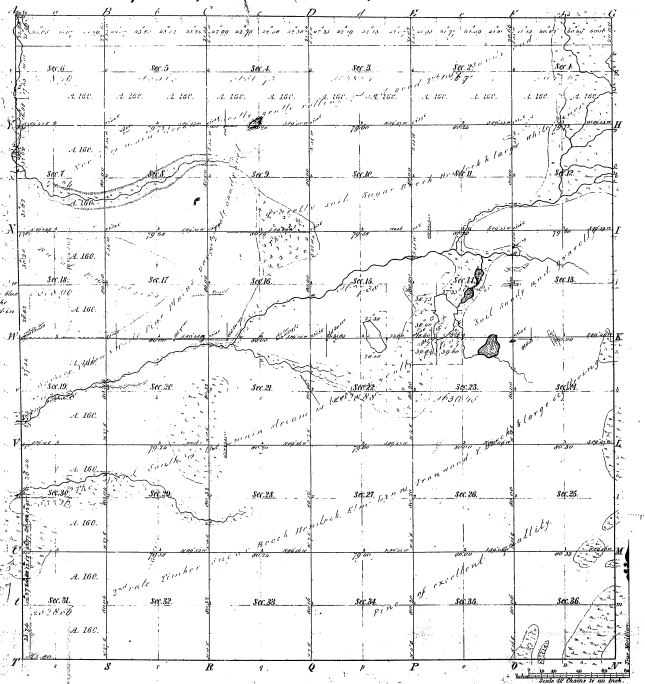

Note
Old corners noted in blue show the marks of the original Survey found in the Township

Meanders of								
Posts	Courses	Ch. Lk.	Posts	Courses	Ch. Lk.	Posts	Courses	Ch. Lk.

Total number of Acres 22526.53

	Surveys Designated	By Whom Surveyed	Date of Contract	Amount of Surveys	When Surveyed	When Sup. Gen. Ld. and ch. d. in the Sup. Gen. Ld. acct.
E. Bdy.	Township lines	James H. Mullett	Feby. 19. 1839.	6. 00. 00.	2nd Qua. 1839.	
	Subdivisions	Lucius Lyon	April 19. 1850.	41. 05. 90.	2nd Qua. 1850.	
S. Bdy.	Resurveyed by	Lucius Lyon	April 19. 1850.	5. 65. 00.	2nd Qua. 1850.	

The above Map of Township No. 27 North of Range No. 7 West of the Principal Meridian Michigan is hereby conformable to the field notes of the survey thereof on file in this Office, which have been examined and approved.

Surveyor General's Office
Detroit Aug. 1 1850

Charles Noble
Surv. Genl.