


Township N<sup>o</sup> 18 R. Range N<sup>o</sup> 16 West Mer. (Mich.)

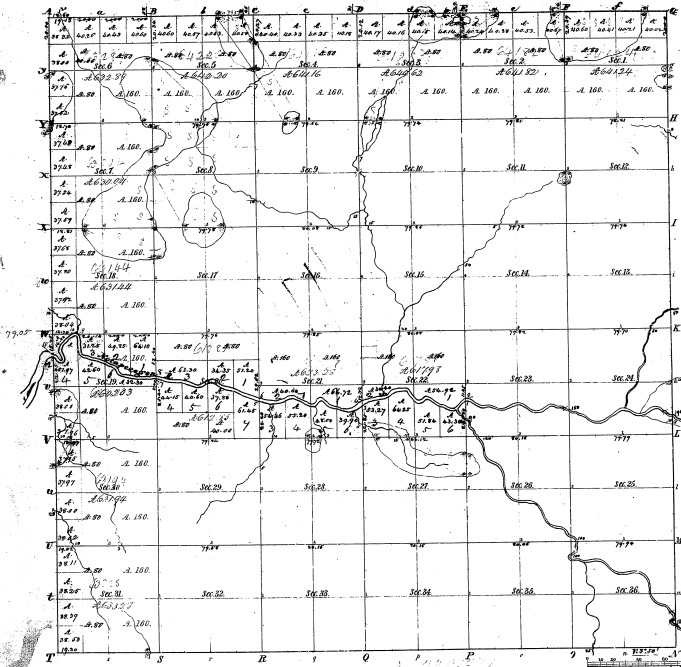

Memoranda of Polygonum Closes.					
Publ Course	Area	Publ Course	Area	Publ Course	Area
