Township No. 20 N. Range No. 15 W. (Mich.)

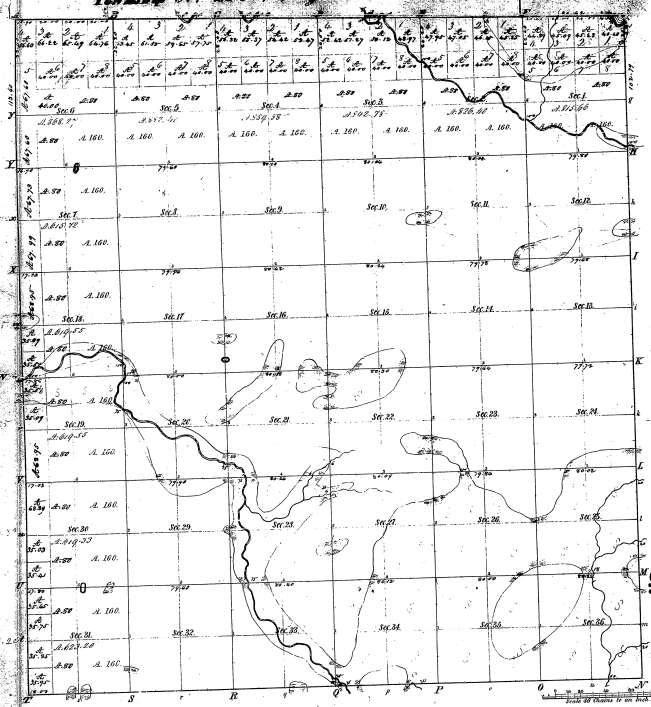

Meanders of part of a Lake in Section 1							
Posts	Courses	Ch. Lks.	Posts	Courses	Ch. Lks.	Posts	Courses	Ch. Lks.
2	S 39 E	8.00						
1	N 76 E	4.00						

10-2

Total number of Acres 24,192.44

Surveys Designated	By Whom Surveyed	Date of Contract	Amount Ch. Lks.	When Surveyed	When approved and ch^d in the Surr. Genl's Office
Township lines	Mathew Birdsall	Feb. 4th 1837	16.74.37	2d qr. 1838	3d qr. 1838
Subdivisions	John Kinsey	Feb. 4th 1837	61.52.70	3d qr. 1839	3d qr. 1839
N. Boundary	Same	Nov. 4th 1836	5.76.90	4th qr. 1837	3d qr. 1838

The above Map of Township No. 20 North of Range No. 15 West of the Principal Meridian Michigan is strictly conformable to the field notes of the survey thereof on file in this Office, which have been examined and approved.

Surveyor General's Office
Cincinnati Aug. 10th 1839

C. S. Ellis
Spec. Gent.